IREDELL COUNTY HEALTH DEPARTMENT

STATESVILLE 704-878-5305 $0.00 Paid MOORESVILLE 704-664-5281

IMPROVEMENT PERMIT / AUTHORIZATION TO CONSTRUCT / OPERATION PERMIT / EXISTING SYSTEM INSPECTION

PERMIT# 122725 PIN# 4645-18-8289 DATE 5/17/05

OWNER OR CONTRACTOR Travis Drake PHONE: Business 435-531-1644 Home 704-254-8957

ADDRESS 9510 University City Blvd Suite 102-210 Charlotte NC 28213

LOCATION Alcove, TR Templeton, TR Henry Ln, on Rt

SUBDIVISION Grimes Loop BLOCK / SECTION ____ LOT 21 LOT AREA 0.70 Ac SITE CLASS. PS DESIGN FLOW 360 L.T.A.R. 0.3

Septic Tank: 1000 Gallons; STB 312 Date 4/18/05

Pump Tank: ____ Gallons; PT ____ Date ____

Pump Make: ____ Model ____ Serial No. ____

Nitrification Field: No Fields 1 Square Feet 900 Linear Feet 300

No Lines 4@75' Trench Width 36" Max Trench Bottom Depth 36" Gravel Depth ____

☒ New System ☐ Repair System Type: I, II, (III) IV, V, VI

System Description: Gravity 25% Reduct

Repair System Description: Pump 25% Reduction

Maintenance Agreement Required: ☐ Yes ☒ No

☒ House/Mod. Home ☐ Mobile Home ☐ Business ☐ Other

No. Bedrooms 3 No. Bathrooms ____ No. Employees ____

☐ Slab ☒ Crawl Space ☐ Basement w/plumbing ☐ Basement wo/plumbing


Water Supply: ☒ Individual ☐ Public ☐ Community

Comments:/Conditions:


1" = 50'

Comments:/Conditions:

INITIAL SITE SKETCH

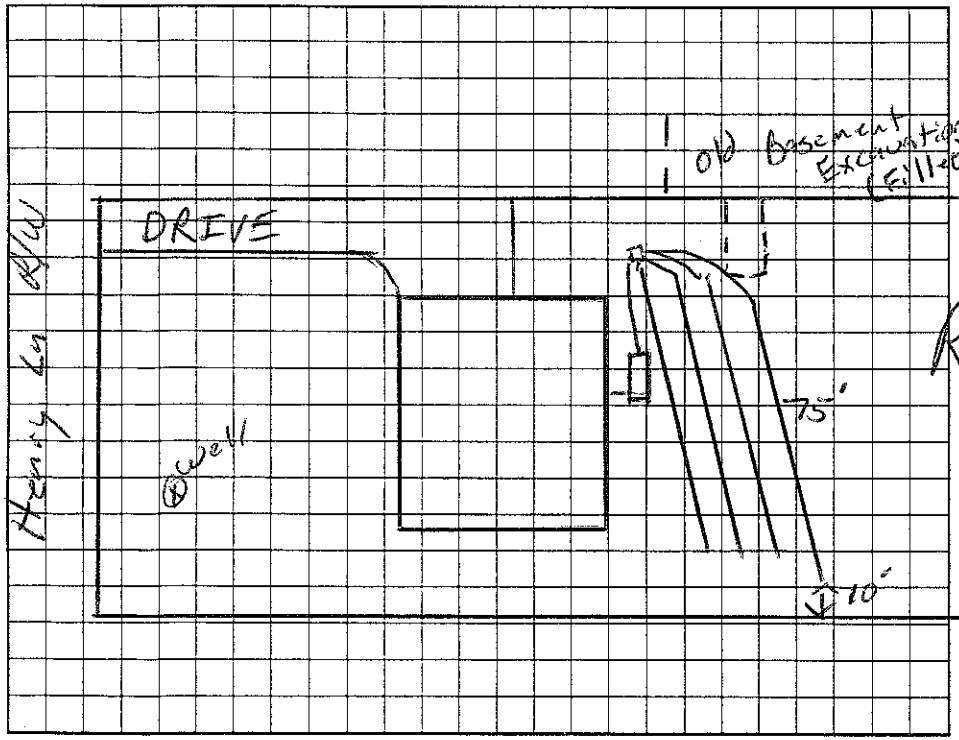

AS BUILT SKETCH

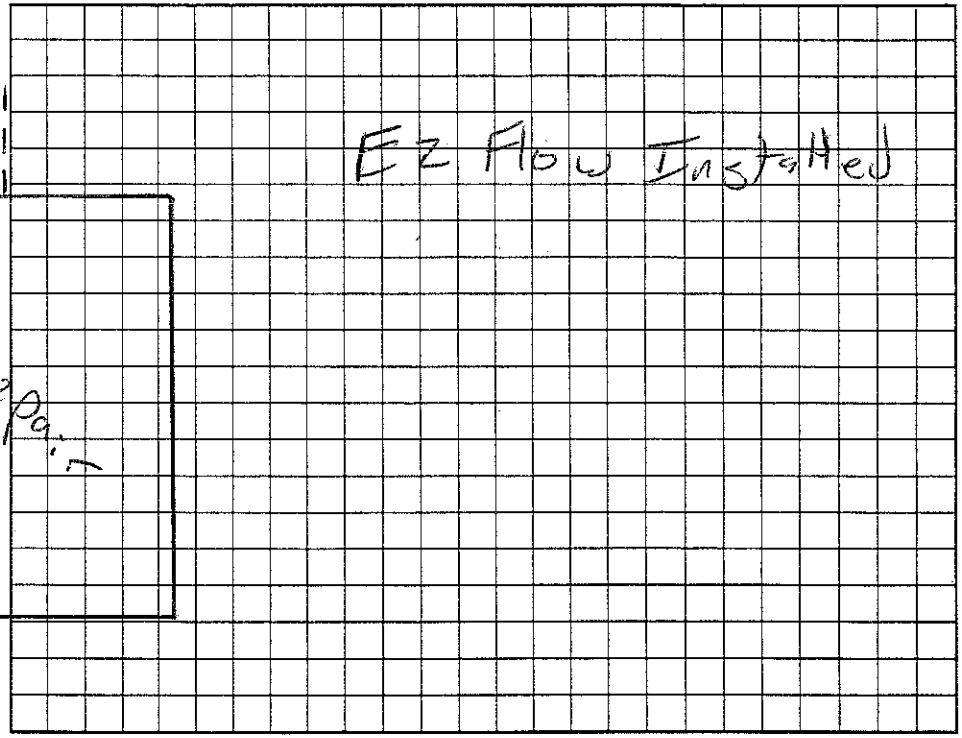

Permit can be suspended or revoked if any false information is supplied toward securing the permit/any unauthorized changes are made to the site/any unauthorized changes are made in the installation of the system. Improvement Permit with plat valid without expiration. Improvement Permit with site plan valid for sixty months. Authorization to Construct is valid for a period equal to that of Improvement Permit – not to exceed sixty months.

Signed: ____ date 5-17-05 Installed by: Gerald Tucker

Improvement Permit by: RS date 5/17/05 Operation Permit by: RS date 5/19/05

Authorization to Construct by: RS date 5/17/05 Existing System Inspection by: ____ date ____

HEALTH DEPT. COPY: WHITE OWNER COPY (FINAL): YELLOW OWNER COPY (INITIAL): PINK