IREDELL COUNTY HEALTH DEPARTMENT

STATESVILLE 704-878-5305 MOORESVILLE 704-664-5281

IMPROVEMENT PERMIT / AUTHORIZATION TO CONSTRUCT / OPERATION PERMIT / EXISTING SYSTEM INSPECTION

PERMIT# 125487 PIN# 4645-18-8591 DATE 8/16/05

OWNER OR CONTRACTOR Russ Graham PHONE: Business 704 528 9170 Home

ADDRESS 105 Wild Wood Cove Troutman NC 28166

LOCATION Alcove, TR Templeton, TR Henry Ln 4th on Rt

SUBDIVISION Grimes Prop. BLOCK / SECTION LOT 4 LOT AREA 0.70 AC SITE CLASS. PS DESIGN FLOW 480 L.T.A.R. 0.3

Septic Tank: 1000 Gallons; STB 825 Date 5/30/05
Pump Tank: 1000 Gallons; PT 302 Date 5/14/05
Pump Make: Zoeller Model N98 Serial No.
Nitrification Field: No Fields 1 Square Feet 1200 Linear Feet 400
No Lines 4@100' Trench Width 36" Max Trench Bottom Depth 36" Gravel Depth —

☒ New System ☐ Repair System Type: I, II, (III), IV, V, VI
System Description: Pump 25% Reduction
Repair System Description: PLP panel Block
Maintenance Agreement Required: ☐ Yes ☒ No

☒ House/Mod. Home No. Bedrooms 4
☐ Mobile Home No. Bathrooms
☐ Business No. Employees
☐ Other


☐ Slab ☒ Crawl Space ☐ Basement w/plumbing ☐ Basement wo/plumbing

Water Supply: ☐ Individual ☐ Public ☐ Community

Comments:/Conditions:


Comments:/Conditions:

INITIAL SITE SKETCH

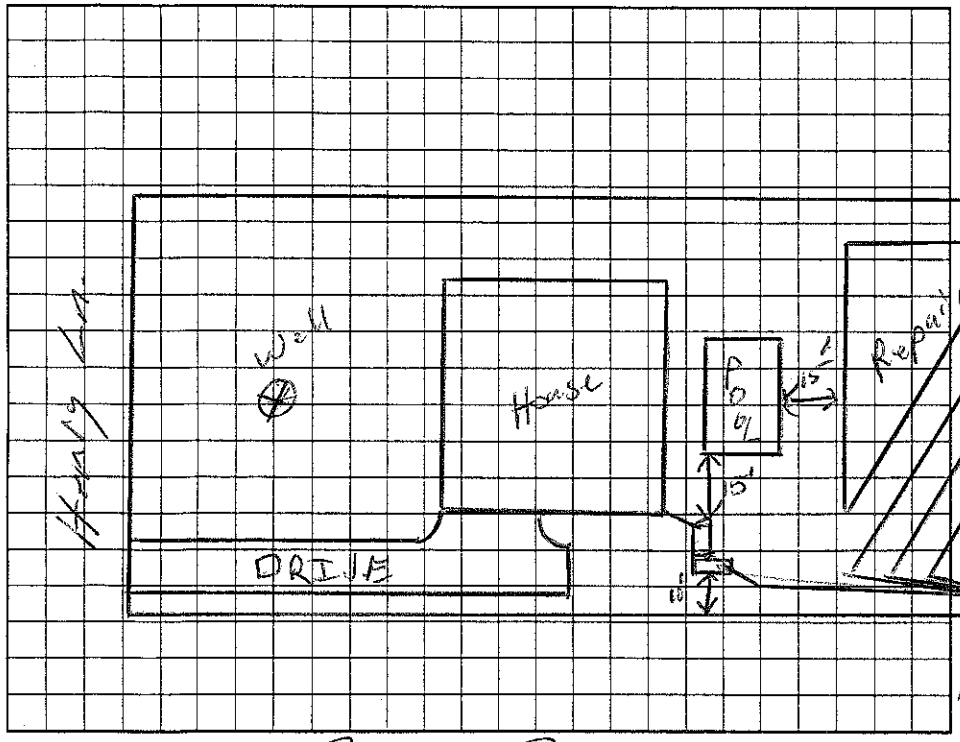

AS BUILT SKETCH

Infiltrator Quick 4 Installed

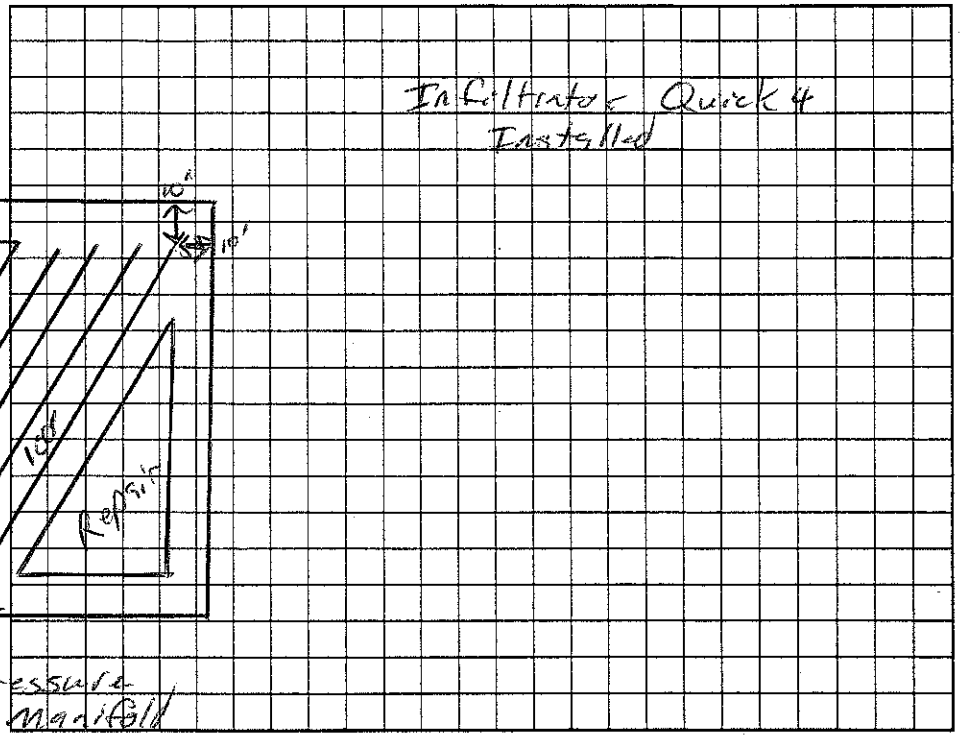

Permit can be suspended or revoked if any false information is supplied toward securing the permit/any unauthorized changes are made to the site/any unauthorized changes are made in the installation of the system. Improvement Permit with plat valid without expiration. Improvement Permit with site plan valid for sixty months. Authorization to Construct is valid for a period equal to that of Improvement Permit – not to exceed sixty months.

Signed: date 8/16/05 Installed by: Rowan Septic

Improvement Permit by: RS date 8/16/05 Operation Permit by: RS date 9/27/05

Authorization to Construct by: RS date 8/16/05 Existing System Inspection by: date

HEALTH DEPT. COPY: WHITE OWNER COPY (FINAL): YELLOW OWNER COPY (INITIAL): PINK