IREDELL COUNTY HEALTH DEPARTMENT

Redraw #10

STATESVILLE 704-878-5305 MOORESVILLE 704-664-5281

IMPROVEMENT PERMIT / AUTHORIZATION TO CONSTRUCT / OPERATION PERMIT / EXISTING SYSTEM INSPECTION

PERMIT# 137448 PIN# 4645189608 4645-18-9715 DATE 8/7/07

OWNER OR APPLICANT Charles Goodin PHONE: Business 704-363-7302 Home 704-864-3499

ADDRESS 684 Normandy Rd. Mooresville NC

LOCATION Alcove Rd. TR on Templeton TR Henry Ln on Right (129 Henry Ln.)

SUBDIVISION _____ BLOCK / SECTION _____ LOT _____ LOT AREA ±.843 ac SITE CLASS. PS DESIGN FLOW 480gpd L.T.A.R. .225 gpd/ft²

Septic Tank: 1000 Gallons: STB 1017 Date 2/19/08

Pump Tank: _____ Gallons: PT _____ Date _____

Pump Make: _____ Model _____ Serial No. _____

Nitrification Field: No Fields 1 Square Feet 2133 Linear Feet 533'

No Lines 4 @ 133' Trench Width 36" Max Trench Bottom Depth 19"

☑ New System ☐ Repair ☐ Expansion System Type: I (II) III IV V VI

System Description: 25% Reduction

Repair System Description: 50% Reduction

Maintenance Agreement Required: ☐ Yes ☑ No Initial

☑ House/Mod. Home ☐ Mobile Home ☐ Business ☐ Other

No. Bedrooms 4 No. Persons ____ No. Employees ____

Water Supply: ☑ Individual ☐ Public ☐ Community

Gravel Depth N/A ☒ Gravity ☐ Pressure ☐ Slab ☑ Crawl Space ☐ Basement w/plumbing ☐ Basement wo/plumbing


Comments:/Conditions (1) Trench bottom at 18" max 19"

(2) Install trenches on contour


(3) Licensed soil scientist Michael Athanas contributed to soil data and system layout for this site.

Comments:/Conditions:

INITIAL SITE SKETCH

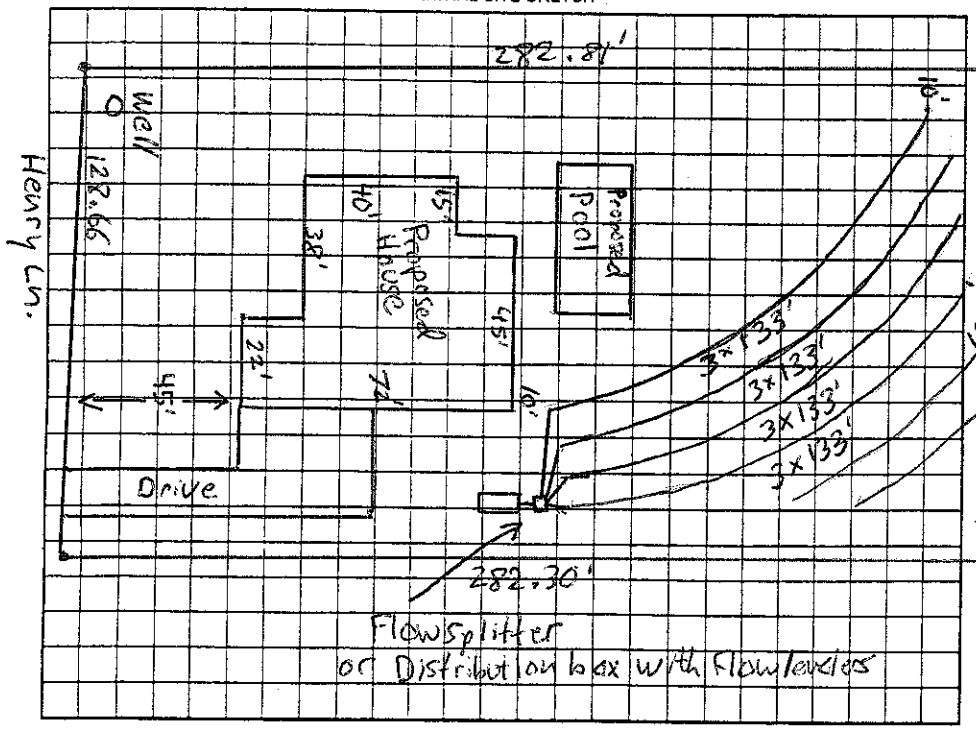

AS BUILT SKETCH

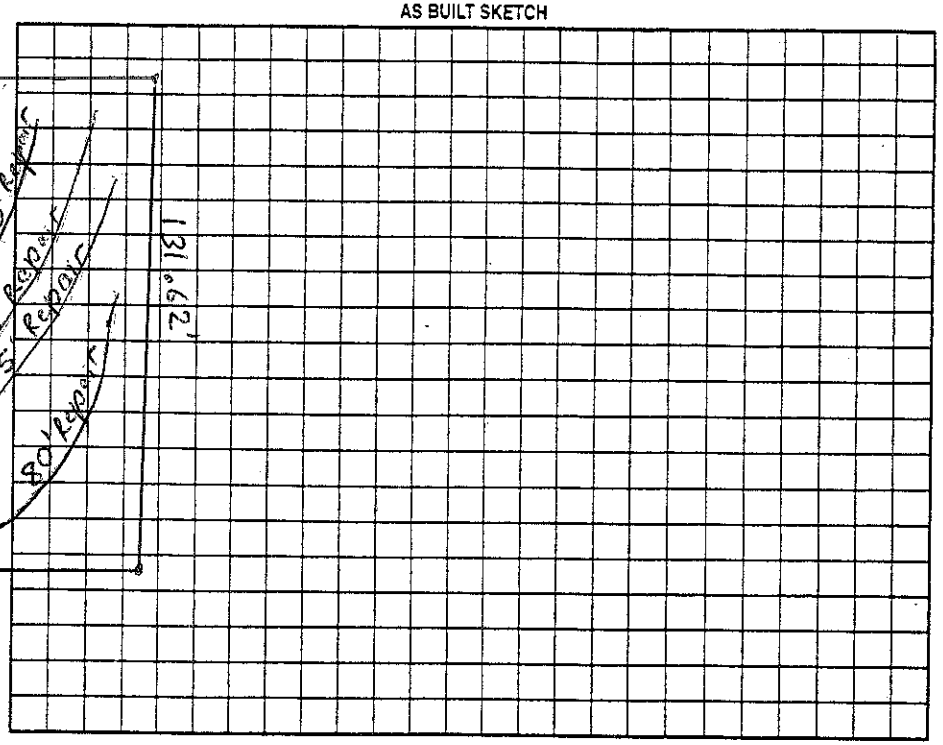

Permit can be suspended or revoked if any false information is supplied toward securing the permit/any unauthorized changes are made to the site/any unauthorized changes are made in the installation of the system. Improvement Permit with plat valid without expiration ☐ Improvement Permit with site plan valid for sixty months ☑ Authorization to Construct is valid for a period equal to that of Improvement Permit – not to exceed sixty months.

omit →

Signed: Anthony Coker Jr. date 8-8-07

Improvement Permit by: Anthony Coker Jr. date 8-7-07

Authorization to Construct by: Anthony Coker Jr. date 8-7-07

Installed by: Dunbar Grading

Operation Permit by: Wade Sparks RS. date 3/20/09

Existing System Inspection by: _____ date _____

HEALTH DEPT. COPY: WHITE OWNER COPY (FINAL): YELLOW OWNER COPY (INITIAL): PINK