IREDELL COUNTY HEALTH DEPARTMENT

STATESVILLE 704-878-5305 130.00 Paid MOORESVILLE 704-663-5281 10100

IMPROVEMENT PERMIT / AUTHORIZATION TO CONSTRUCT / OPERATION PERMIT / EXISTING SYSTEM INSPECTION

PERMIT# 108152 PIN# 4645-18-9936 DATE 9/15/03

OWNER OR CONTRACTOR D.S. Rushing Inc PHONE: Business 704 896-5766 Home

ADDRESS 221 Boxelder RD Mooresville NC 28115

LOCATION Alcove, TR Templeton, TR Henry on Rt

SUBDIVISION Kelly Cove BLOCK / SECTION LOT 7 LOT AREA 0.61AC SITE CLASS PS DESIGN FLOW 480 L.T.A.R. 0.03

Septic Tank: 1000 Gallons; STB 794 Date 10/20/03
Pump Tank: 1000 Gallons; PT 7 Date 11/9/03
Pump Make: Goulds Model WS0F511 Serial No.
Nitrification Field: No Fields 1 Square Feet 1200 Linear Feet 900
No Lines 5@80' Trench Width 36" Max Trench Bottom Depth 36" Gravel Depth —

☒ New System ☐ Repair System Type: I, II, III, IV, V, VI
System Description: Pump 25% Reduction
Repair System Description: LP Road Block
Maintenance Agreement Required: ☐ Yes ☒ No

☒ House/Mod. Home ☐ Mobile Home ☐ Business ☐ Other
No. Bedrooms 4 No. Bathrooms 2.5 No. Employees


☐ Slab ☐ Crawl Space ☒ Basement w/plumbing ☐ Basement wo/plumbing

Water Supply: ☒ Individual ☐ Public ☐ Community


Comments:/Conditions:

Comments:/Conditions:

INITIAL SITE SKETCH

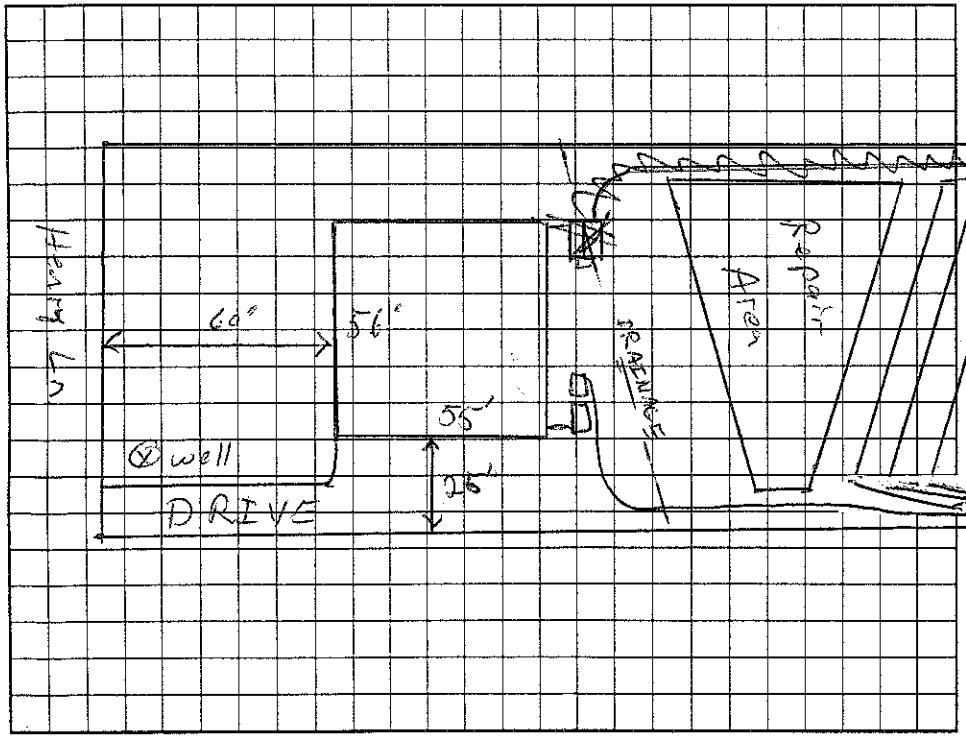

AS BUILT SKETCH

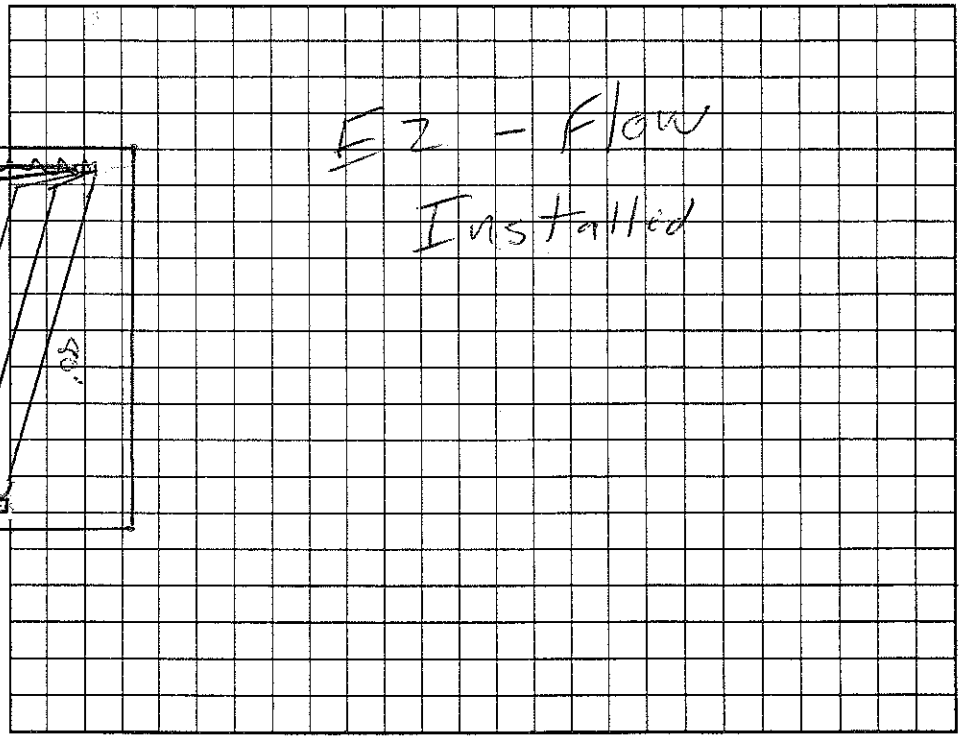

Permit can be suspended or revoked if any false information is supplied toward securing the permit/any unauthorized changes are made to the site/any unauthorized changes are made in the installation of the system. Improvement Permit with plat valid without expiration/Improvement Permit with site plan valid for sixty months. Authorization to Construct is valid for a period equal to that of Improvement Permit – not to exceed sixty months.

Signed: David Rushing date 9-16-03 Installed by: Bob McCarver

Improvement Permit by: RS date 9/15/03 Operation Permit by: RS date 2/5/04

Authorization to Construct by: RS date 9/15/03 Existing System Inspection by: date

HEALTH DEPT. COPY: WHITE OWNER COPY (FINAL): YELLOW OWNER COPY (INITIAL): PINK