IREDELL COUNTY HEALTH DEPARTMENT - *ENVIRONMENTAL HEALTH* ☐ STATESVILLE OFFICE 704-878-5305 ☒ MOORESVILLE OFFICE 704-664-5281

IMPROVEMENT PERMIT / AUTHORIZATION TO CONSTRUCT / OPERATION PERMIT / EXISTING SYSTEM INSPECTION

PERMIT # 166458 PIN # 4645-19-1299 DATE 5-24-11

OWNER ROBERT CoxFox APPLICANT: SAME PHONE: Home/Cell # 704-534-9221 Business #

SITE ADDRESS 140 KEATS RD MVILLE 28117 OWNER / APPLICANT ADDRESS

SITE DIRECTIONS ALCOVE, TEMPLETON, HENRY, TL KEATS, 140

SUBDIVISION BOB WHITE BLOCK / SECTION LOT # LOT AREA 1 AC DESIGN FLOW 360 L.T.A.R. NOT TAKEN

Septic Tank Ex 1000 Gallons: STB Date

Pump Tank Gallons: P T Date

Pump Make Model Serial #

No. Nitrification Fields: No. Lines Lineal Feet

Trench Width Max. Trench Bottom Depth Gravel Depth

☐ New System ☐ Repair ☐ Expansion System Type I (II) III IV V VI

System Description: GRAVEL BED

Repair System Description:

Maintenance Agreement Required ☐ YES ☒ NO

☐ GRAVITY ☐ PRESSURE

☒ Residence No. Bedrooms 3

☐ Business No. Persons

☒ Other No. Employees


☐ Slab ☒ Crawl Space

☐ Basement w/plumbing ☐ Basement w/o plumbing


Water Supply: ☒ Private ☐ Public ☐ Community

Comments / Conditions: DECK ① SYSTEM LOOKED GOOD @ TIME OF INSPECTION

INITIAL SITE SKETCH

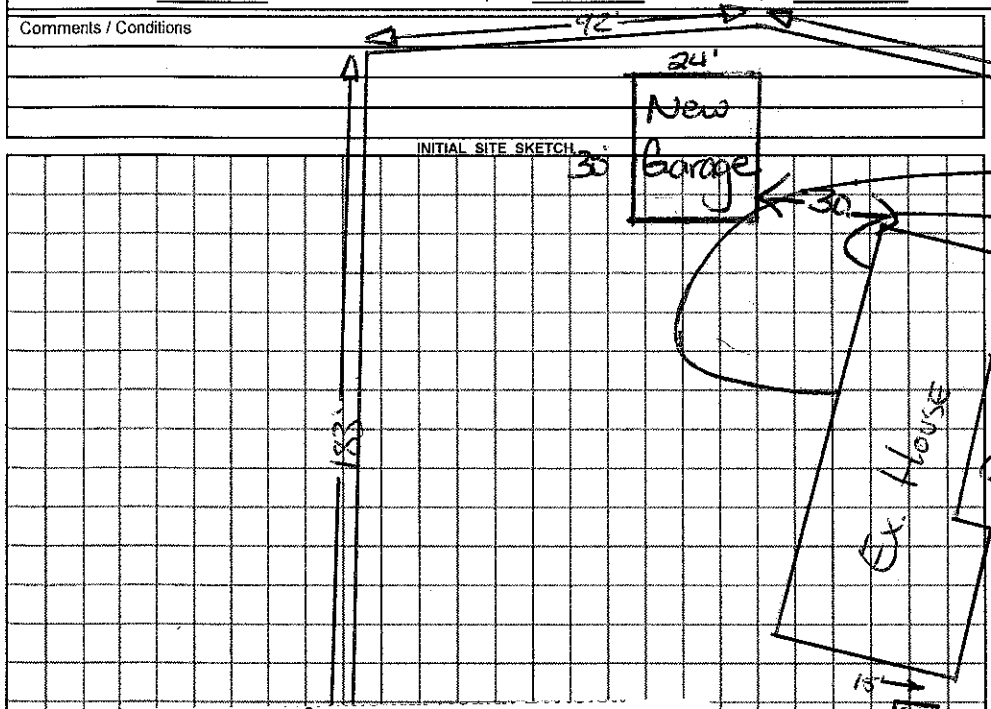

AS BUILT SKETCH

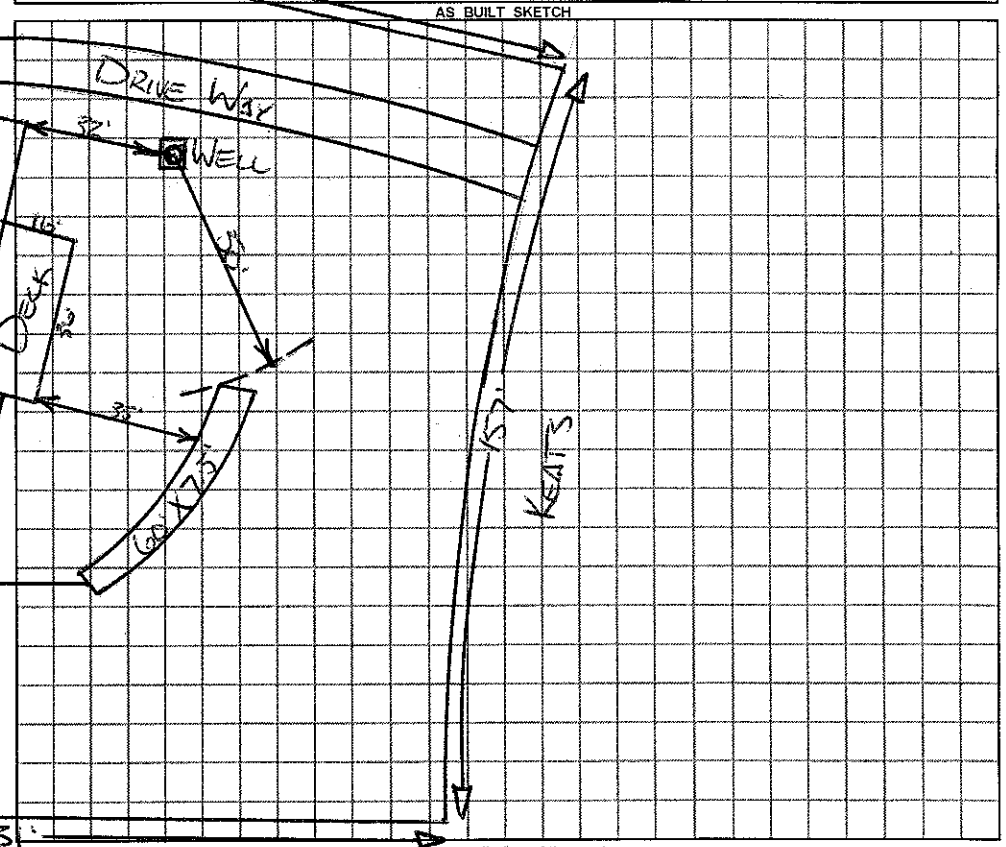

Location of the proposed Garage addition does not appear to impact the existing on-site septic system.**NOTE: Any Building must be at least 5ft from Septic

Date: 7/10/13

ICHD-Environmental Health Division

Permit can be suspended or revoked if any false information is supplied toward securing the permit / any unauthorized changes are made to the site / any unauthorized changes are made in the installation of the system.

☐ ***IMPROVEMENT PERMIT*** with plat valid without expiration. ☐ ***IMPROVEMENT PERMIT*** with plat ~~valid without expiration~~ site plan valid 60 mo. ☐ ***AUTHORIZATION TO CONSTRUCT*** valid for period equal to IMPROVEMENT PERMIT--not to exceed 60 mo.

Owner / Applicant Signature: Date Installed by:

IMPROVEMENT PERMIT by: REHS Date OPERATION PERMIT by: REHS Date

AUTHORIZATION TO CONSTRUCT by: REHS Date Existing System Inspected by: REHS Date 5-24-11

YOU SHOULD CONTACT A LOCATOR SERVICE PRIOR TO ANY EXCAVATION

White Copy – Environmental Health YELLOW COPY (Final) Owner / Applicant PINK COPY (Initial) Owner / Applicant