Permit_ID:

PIN_ID: 4645191299.000

Subdivision_Name: BOB WHITE

Section_Number:

Lot_Number:

OP_Issued_Date: 1/13/1966

System_Class: Type II

Certified_Operator:

IREDELL COUNTY HEALTH DEPARTMENT

Statesville Phone TR 3-7271 Mooresville Phone NO 3-1271

PERMIT TO INSTALL SEPTIC TANK

Permit No. _____ Permit Date 13 Jan 1966

Owner Robert Stanley Address Mooresville, N.C.

Installed By Owner Address Mooresville


Location of Property Bob White Sub-division

Tank		Capacity		Length of Lines		Fixtures	
Block	(✓)	1000	(✓)	225'	(✓)	No. of Baths	( )
Precast	( )	1250	( )	250'	( )	Dishwasher	( )
		1500	( )	Other _____		Garbage Grdr.	( )
		Other _____				Other _____	

NOTIFY HEALTH DEPARTMENT AT LEAST EIGHT HOURS BEFORE TANK IS TO BE INSPECTED.

Final Inspection 17 Jan 1966 Approved (X) Disapproved ( )

Remarks _____

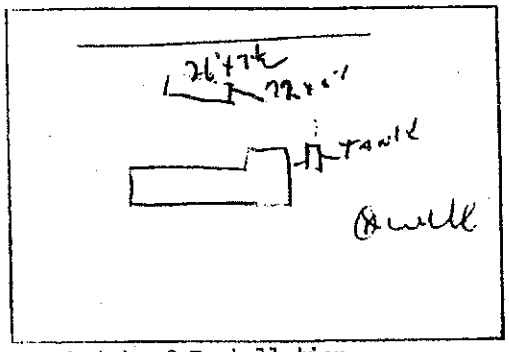

Sketch of Installation

Troy Scoggin
Sanitarian