IREDELL COUNTY HEALTH DEPARTMENT

Statesville Phone TR 3-7271 Mooresville Phone NO 3-1271

PERMIT TO INSTALL SEPTIC TANK

Permit No. _____ Permit Date 13 Jan 1966

Owner Ribal Stanley Address Mooresville, N.C.

Installed By Yokley Address Thomasville


Location of Property Rob White Sub-division

Tank		Capacity		Length of Lines		Fixtures	
Block	( )	1000	( )	225'	( )	No. of Baths	( )
Precast	( )	1250	( )	250'	( )	Dishwasher	( )
		1500	( )	Other _____		Garbage Grdr.	( )
		Other _____				Other _____	

NOTIFY HEALTH DEPARTMENT AT LEAST EIGHT HOURS BEFORE TANK IS TO BE INSPECTED.

Final Inspection 13 Jan 1966 Approved (X) Disapproved ( )

Remarks _____

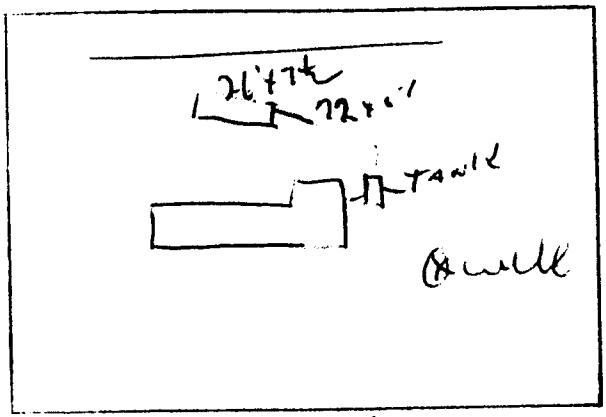

Sketch of Installation

Troy Sawyer
Sanitarian