IREDELL COUNTY HEALTH DEPARTMENT

STATESVILLE 704-878-5305 MOORESVILLE 704-664-5281

IMPROVEMENT PERMIT / AUTHORIZATION TO CONSTRUCT / OPERATION PERMIT / EXISTING SYSTEM INSPECTION

PERMIT # NA PIN # 4645 19 3276 DATE 7/7/09

OWNER or APPLICANT KAREN LILLY PHONE: Business Home: 704-677-4672

OWNER or APPLICANT ADDRESS 150 KEATS RD. MOORESVILLE, NC. 28115

LOCATION / DIRECTIONS ALCOVE TR ON TEMPLETON, RAT OAK RAT STOA SIGN ON (R) JUST BEFORE KELLY POINT LN.

SUBDIVISION No BLOCK / SECTION LOT # No LOT AREA DESIGN FLOW L.T.A.R. .3

Septic Tank Concrete 1000 Gallons: STB 1799 Date 6/5/09

Pump Tank Gallons: P.T. Date

Pump Make Model Serial #

Nitrification Field No Fields 1 No Lines 3 Linear Feet 300

Trench Width 3' Max. Trench Bottom Depth 3' Gravel Depth No

☐ New System ☒ Repair ☐ Expansion System Type I (II) III IV V VI

System Description:

Repair System Description: GR-25% REDUCTION

Maintenance Agreement Required ☐ YES ☒ NO

☒ GRAVITY ☐ PRESSURE

☒ Residence No. Bedrooms 3

☐ Business No. Persons

☐ Other No. Employees

☐ Slab ☐ Crawl Space


☐ Basement w/plumbing ☒ Basement w/o plumbing

Water Supply: ☒ Private ☐ Public ☐ Community

Comments / Conditions: Eq OLD BED. ← Not In Use

Comments / Conditions: Red Fitter

INITIAL SITE SKETCH

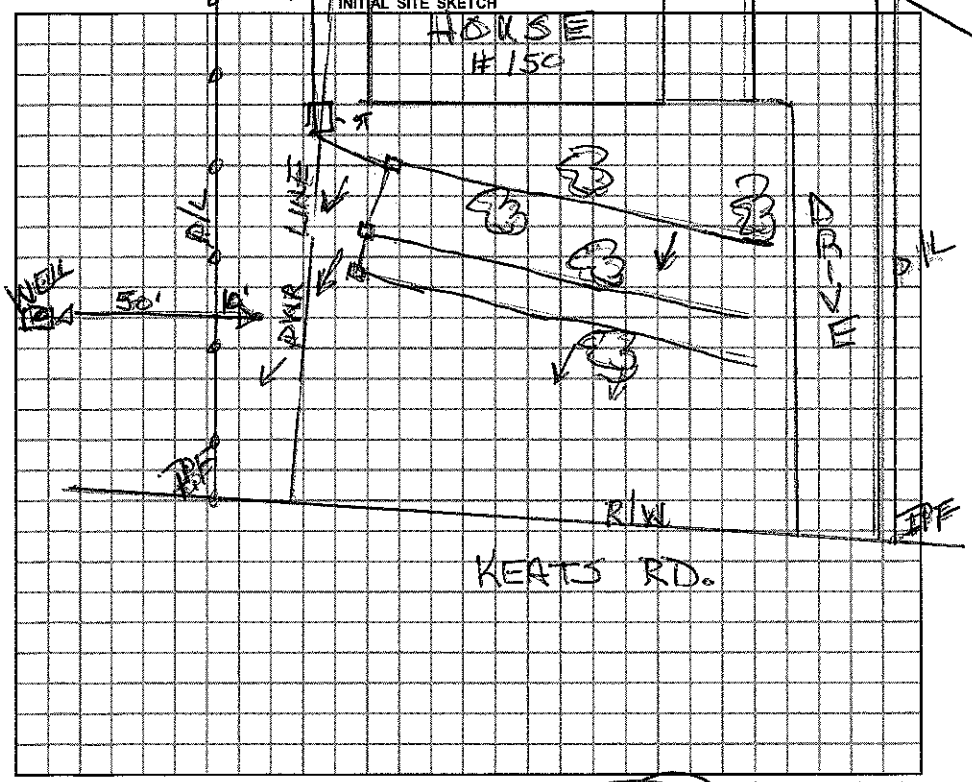

AS BUILT SKETCH

Adding Deck to House, Footers must be at least 5ft from existing Septic Tank. (Old Drainfield Bed No longer being used)

The proposed / existing Deck addition does not appear to impact the existing septic system.

**NOTE: Keep Deck footers 5Ft from ST

Marquis Dickson REHS

Date 3/4/2010

ICHD-Environmental Health Division

Permit can be suspended or revoked if any false information is supplied toward securing the permit / any unauthorized changes are made to the site / any unauthorized changes are made in the installation of the system.

☐ *IMPROVEMENT PERMIT w / plat valid without expiration.* ☐ *IMPROVEMENT PERMIT w / site plan valid for 60 mos.* ☒ *AUTHORIZATION TO CONSTRUCT valid for period equal to IMPROVEMENT PERMIT-not to exceed 60 mo.*

Owner / Applicant Signature: Karen Lilly (RW) Date

Improvement Permit by: Wesley Sparks R.S. Date 7/7/09

Authorization to Construct by: Wesley Sparks R.S. Date 7/7/09

YOU SHOULD CONTACT A LOCATOR SERVICE PRIOR TO ANY EXCAVATION.

Installed by: Russell C Williams

Operation Permit by: Raymond Date: 7/9/09

Existing System Inspected by: Date:

WHITE COPY Environmental Health YELLOW COPY (Final) Owner / Applicant PINK COPY (Initial) Owner / Applicant