IREDELL COUNTY HEALTH DEPARTMENT

STATESVILLE 704-878-5305 MOORESVILLE 704-664-5281

IMPROVEMENT PERMIT / AUTHORIZATION TO CONSTRUCT / OPERATION PERMIT / EXISTING SYSTEM INSPECTION

PERMIT # 1165398 PIN # 4645-19-3689 DATE 3-17-11

OWNER or APPLICANT Ronald Lu PHONE: Business 704-451-6177 Home:

OWNER or APPLICANT ADDRESS 1309 Berkshire Ln Charlotte NC 28262

LOCATION / DIRECTIONS Alcove, TR Templeton, TR Henry, TL Keats, TR Kelly Point, on (L)

SUBDIVISION Bob White BLOCK / SECTION LOT # 2 LOT AREA .549 ac DESIGN FLOW 480 L.T.A.R. .35

Septic Tank Gallons: STB Date

Pump Tank Gallons: P T Date

Pump Make Model EXISTING Serial #

Nitrification Field No Fields No Lines Linear Feet

Trench Width Max. Trench Bottom Depth Gravel Depth

☐ New System ☐ Repair ☐ Expansion System Type I II (III) IV V VI

System Description: Gravity Panel

Repair System Description: LP-Panel / Max Possible

Maintenance Agreement Required ☐ YES ☒ NO

☒ GRAVITY ☐ PRESSURE

☒ Residence No. Bedrooms 4

☐ Business No. Persons

☒ Other No. Employees

☐ Slab ☒ Crawl Space


☐ Basement w/plumbing ☐ Basement w/o plumbing

Water Supply: ☒ Private ☐ Public ☐ Community


Comments / Conditions *NOTE* System was failing before but looked good @ time of inspection. Leaks fixed inside house (per owner)

Comments / Conditions Deck * House vacated @ time of inspection *

INITIAL SITE SKETCH

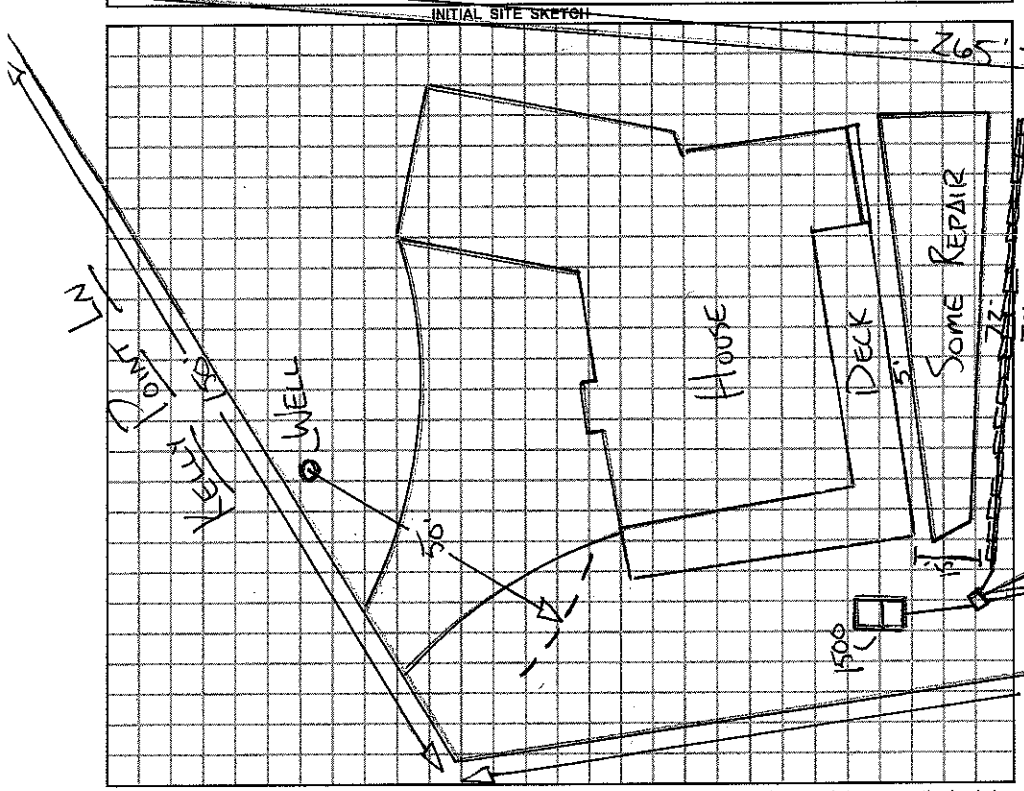

AS BUILT SKETCH

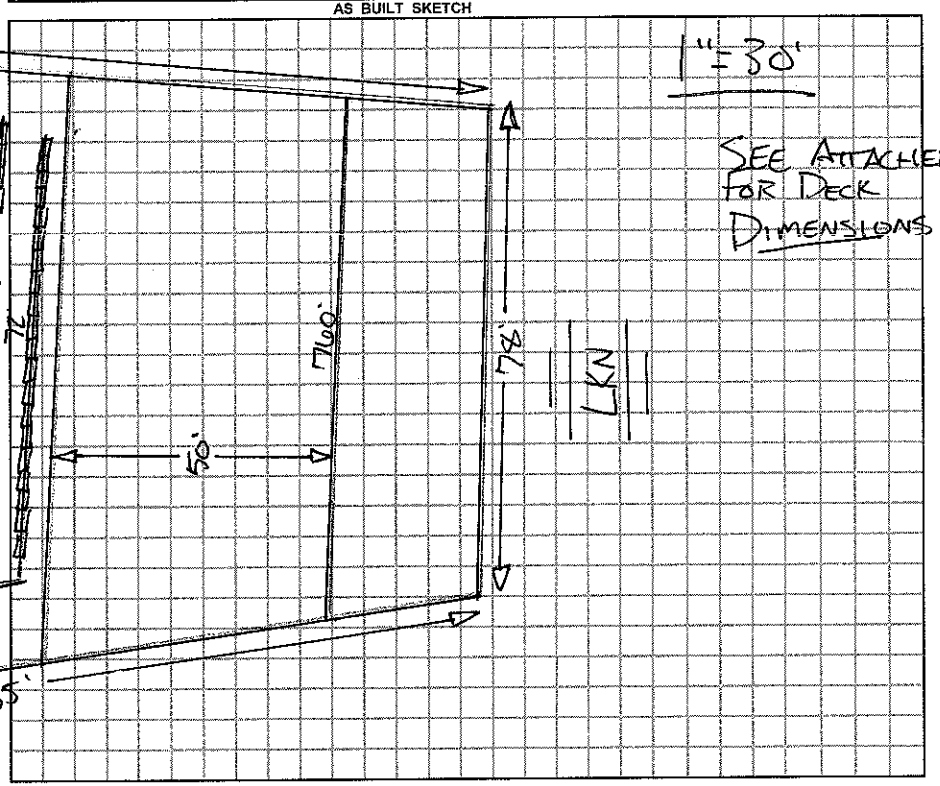

Permit can be suspended or revoked if any false information is supplied toward securing the permit / any unauthorized changes are made to the site / any unauthorized changes are made in the installation of the system.

☐ *IMPROVEMENT PERMIT w / plat valid without expiration.* ☐ *IMPROVEMENT PERMIT w / site plan valid for 60 mos.* ☐ *AUTHORIZATION TO CONSTRUCT valid for period equal to IMPROVEMENT PERMIT-not to exceed 60 mo.*

Owner / Applicant Signature: Date 3/17/11

Improvement Permit by: Date

Authorization to Construct by: Date

Installed by:

Operation Permit by: Date:

Existing System Inspected by: REHS Date:

YOU SHOULD CONTACT A LOCATOR SERVICE PRIOR TO ANY EXCAVATION.

WHITE COPY Environmental Health YELLOW COPY (Final) Owner / Applicant PINK COPY (Initial) Owner / Applicant