4645194803

IREDELL COUNTY HEALTH DEPARTMENT

R A White

Statesville Phone TR 3-7271

Mooresville Phone NO 3-1271

PERMIT TO INSTALL SEPTIC TANK

Permit NO. _____

Permit Date 18 Mar 1966

Owner Jim Bostian Address Lowesville, N.C.

Installed By Reynolds Septic Tank Address Mooresville, N.C.


Location of Property Bob White property Lake Norman

Tank		Capacity		Length of Lines		Fixtures	
Block	( )	800	( )	150'	( )	No. of Baths	( )
Precast	(✓)	900	( )	175'	( )	Dishwasher	( )
		1000	(✓)	200'	( )	Garbage Grdr.	( )
		1100	( )	225'	(✓)	Auto-Washer	( )
		1200	( )	250'	( )	Other	
		Other		Other			

NOTIFY HEALTH DEPARTMENT AT LEAST EIGHT HOURS BEFORE TANK IS TO BE INSPECTED.

Final Inspection 18 Mar 1966 Approved (✓) Disapproved ( )

Remarks

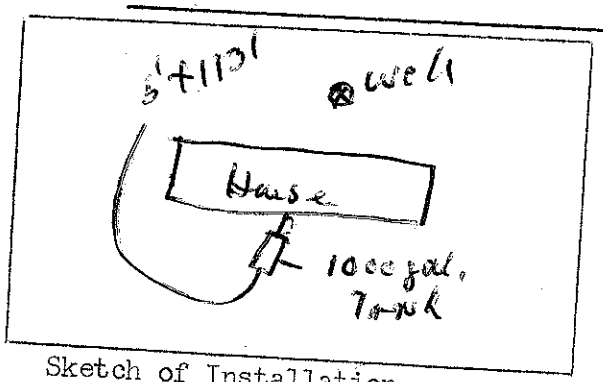

Sketch of Installation

Ray R. Lewis
Sanitarian