$ 130

IREDELL COUNTY HEALTH DEPARTMENT

STATESVILLE 704-878-5305 MOORESVILLE 704-664-5281

IMPROVEMENT PERMIT / AUTHORIZATION TO CONSTRUCT / OPERATION PERMIT / EXISTING SYSTEM INSPECTION

PERMIT# 10477520 PIN# 4645195290 DATE 3-18-2002

OWNER OR CONTRACTOR James & Grace Sisco PHONE: Business 664-1500 ~~Home~~ Cell 351-7928

ADDRESS 161 Castles Gate Dr Mooresville NC 28117

LOCATION Alove Rd TR Templeton TR Henry lot on left before corner lot.

SUBDIVISION Kelly Cove BLOCK / SECTION ____ LOT 2 LOT AREA .68 Acre SITE CLASS PS DESIGN FLOW 360gpd L.T.A.R. .25 to .3

Septic Tank: 1000 Gallons; STB 794 Date 4-8-03
Pump Tank: ____ Gallons; PT ____ Date ____
Pump Make: ____ Model 960 Serial No. ____
Nitrification Field: No Fields 1 Square Feet ~~1080~~ Linear Feet 360'
No Lines 6@~~60~~ 50' Trench Width 36" Max Trench Bottom Depth 36" Gravel Depth N/A

[X] New System [ ] Repair System Type: I, II, III, IV, V, VI
System Description: Gravity - 25% Reduction
Repair System Description: Grav./Pump - Innovative
Maintenance Agreement Required: [ ] Yes [X] No


[X] House/Mod. Home No. Bedrooms 3
[ ] Mobile Home No. Bathrooms 3
[ ] Business No. Employees ____
[ ] Other ____
[ ] Slab [X] Crawl Space [ ] Basement w/plumbing [ ] Basement wo/plumbing

Water Supply: [X] Individual [ ] Public [ ] Community

Comments/Conditions: Keep Septic System at least 10' from PL & 50'-100' from any well.
Driveway must not cross drainfield or ST.

Comments/Conditions: House must setback be at least 80' to front PL.
ST marker installed.

INITIAL SITE SKETCH Scale 1:60

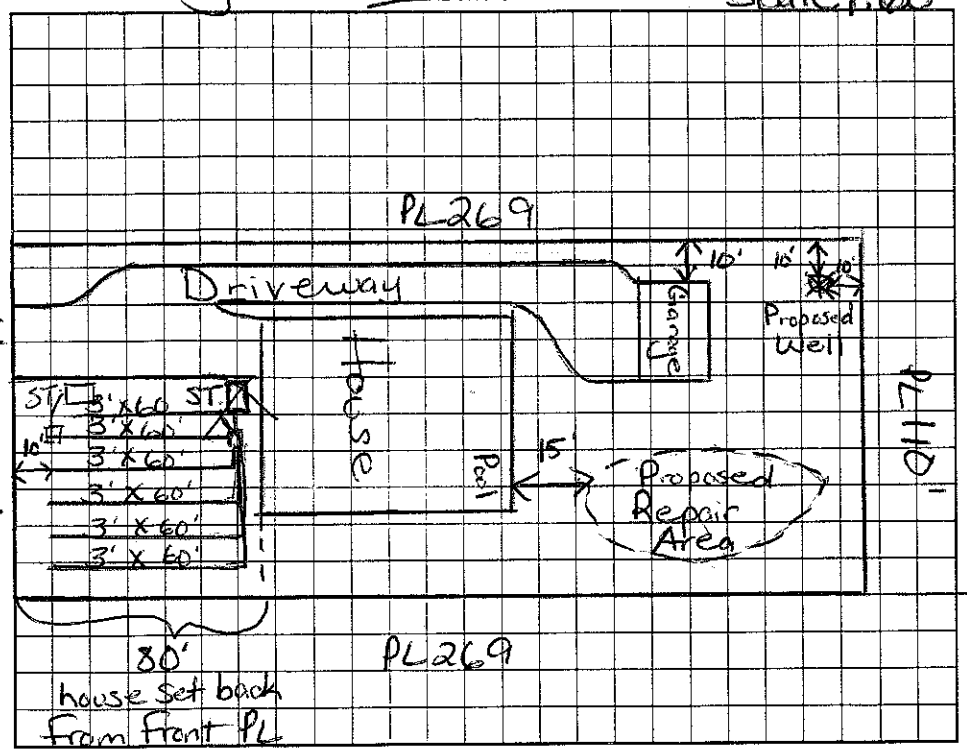

AS BUILT SKETCH

Installed 6-50' lines of EZ Flow (used D-box w/Speed levelers)

Note: Plumbing Stubbed out deep therefore ST had to be moved to ~ 10' off front PL. Okayed with owner prior to installation

Permit can be suspended or revoked if any false information is supplied toward securing the permit/any unauthorized changes are made to the site/any unauthorized changes are made in the installation of the system. Improvement Permit with plat valid without expiration. Improvement Permit with site plan valid for sixty months. Authorization to Construct is valid for a period equal to that of Improvement Permit – not to exceed sixty months.

Signed: James Sisco date ____ Installed by: R&H Inc RS

Improvement Permit by: Maria H Dotson RS date 3-18-2002 Operation Permit by: Maria H Dotson date 5/16/03

Authorization to Construct by: Maria H Dotson RS date 3-18-2002 Existing System Inspection by: ____ date ____

HEALTH DEPT. COPY: WHITE OWNER COPY (FINAL): YELLOW OWNER COPY (INITIAL): PINK