IREDELL COUNTY HEALTH DEPARTMENT

STATESVILLE 704-878-5305 130.00 Paid MOORESVILLE 704-664-5281 10:00

IMPROVEMENT PERMIT / AUTHORIZATION TO CONSTRUCT / OPERATION PERMIT / EXISTING SYSTEM INSPECTION

PERMIT# 114982 PIN# 4645199027 DATE 8/22/03

OWNER OR CONTRACTOR Joseph Johnston PHONE: Business (704) 361-5518 Home

ADDRESS 146 Hampshire Dr Mooresville, NC 28115

LOCATION Alcove Rd TR Templeton TR Henry on right #117 Henry Ln

SUBDIVISION Kelly Cove BLOCK / SECTION LOT 8 LOT AREA .649 Acres SITE CLASS PS DESIGN FLOW 480gpd L.T.A.R. .37

Septic Tank: 1000 Gallons: STB 794 Date 9-29-03
Pump Tank: 1000 Gallons: PT 27 Date 9-9-03
Pump Make: Zoeller Model 53 Serial No.
Nitrification Field: No. Fields 1 Square Feet 1200 Linear Feet ~~400~~ 320
No Lines 4@80 ~~100~~ Trench Width 36" Max Trench Bottom Depth Gravel Depth

☒ New System ☐ Repair System Type: I, II, III, IV, V, VI
System Description: *Pump-25% Reduction
Repair System Description: Pump-LP-Panel Blk
Maintenance Agreement Required: ☐ Yes ☒ No Not Initially

☒ House/Mod. Home No. Bedrooms 4
☐ Mobile Home No. Bathrooms 3½
☐ Business No. Employees
☐ Other


☐ Slab ☒ Crawl Space ☐ Basement w/plumbing ☐ Basement wo/plumbing

Water Supply: ☒ Individual ☐ Public ☐ Community


Comments:/Conditions: Keep Septic System at least 10' from PL & 100' to well.
(IF Contour changes, may have to install 4-80' lines)

Comments:/Conditions: *Note: 25% Reduction = EZ Flow or "Plastic Chamber"
Tanks & lines checked 11/14/03
10/5/09 Pressure set, Conduit sealed
10/7/09 Footer for deck 2'5 ft from tanks cut off

INITIAL SITE SKETCH Scale 1:50

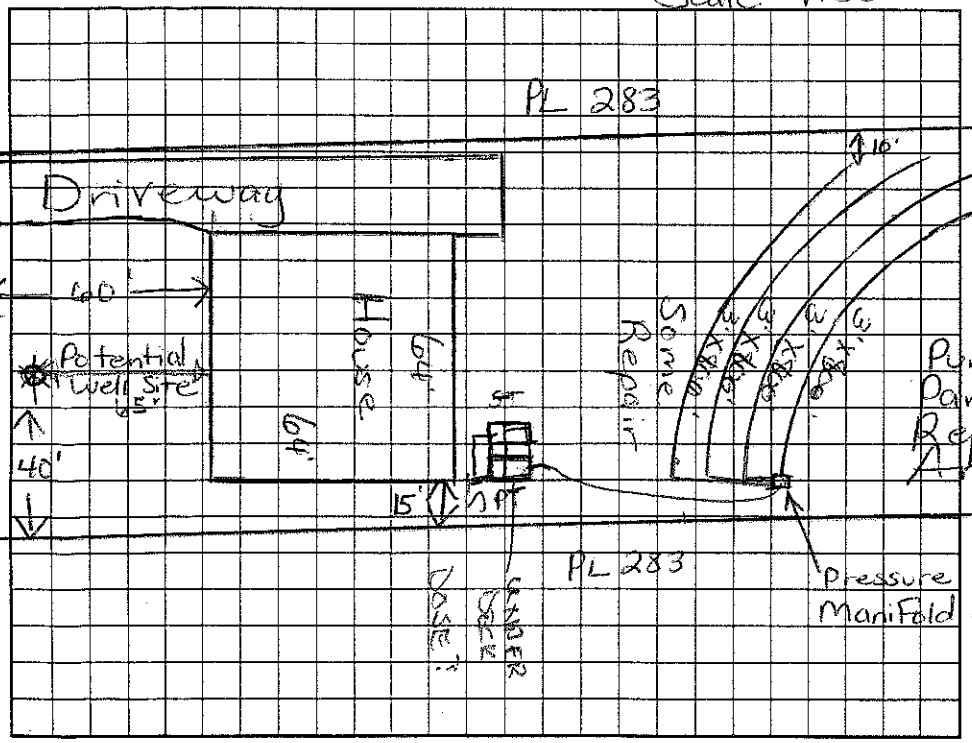

AS BUILT SKETCH

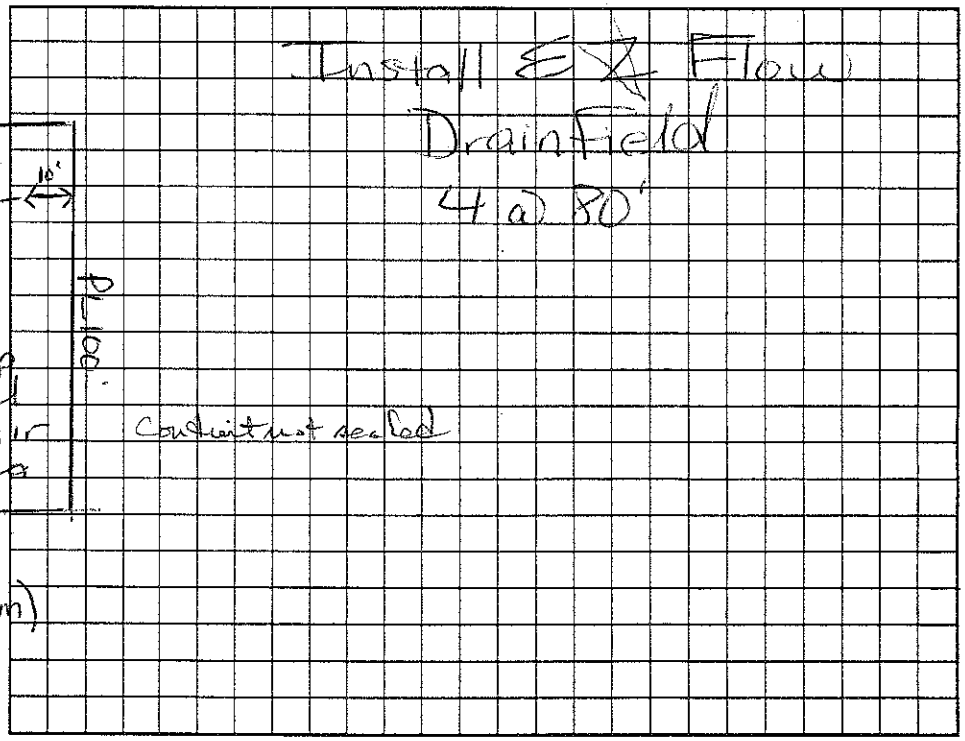

Permit can be suspended or revoked if any false information is supplied toward securing the permit/any unauthorized changes are made to the site/any unauthorized changes are made in the installation of the system. Improvement Permit with plat valid without expiration. Improvement Permit with site plan valid for sixty months. Authorization to Construct is valid for a period equal to that of Improvement Permit – not to exceed sixty months.

Signed: date 8-25-03 Installed by: Reade Evans

Improvement Permit by: Maria H. Dotson RS date 8/25/03 Operation Permit by: Maria H. Dotson RS date 10/7/09

Authorization to Construct by: Maria H. Dotson RS date 8/25/03 Existing System Inspection by: date

HEALTH DEPT. COPY: WHITE OWNER COPY (FINAL): YELLOW OWNER COPY (INITIAL): PINK