DELL COUNTY HEALTH DEPARTMENT

Statesville Office (704) 878-5305 Mooresville Office (704) 660-3625 PERMIT # 178341

IMPROVEMENT PERMIT / AUTHORIZATION TO CONSTRUCT / OPERATION PERMIT / EXISTING SYSTEM

PIN # 4645 19 9137

APPLICANT: Sean Toole APPLICANT ADDRESS:

SITE ADDRESS: 111 Henry Lane, Mooresville PHONE: 407 579-1129 ALT. PHONE:

SITE DIRECTIONS: Williamson Road to Alcove Rd. TR Templeton TR Henry Ln. ~¼ mi. on Right

SUBDIVISION: Kelly Cove SECTION: LOT # 9 LOT AREA: 100'x283' DESIGN FLOW: 600 L.T.A.R.: .25


Septic Tank	1500 (gal)	STB	964	Date	8-30	☒ New System	☐ Repair	☐ Expansion	System Type: I II III (IV) V VI	☒ Residence	No. Bedrooms 5
Pump Tank	1500 (gal)	PT	389	Date	8-30	System Description:	LP PPBPS			☐ Business	No. Persons
Pump Make		Model		Serial #		Repair System Description:	LP PPBPS			☐ Other	No. Employees
# Nitrification Fields	1	# Lines	4	Linear Ft:	400	Maintenance Agreement Required:	☒ YES	☐ NO		☐ Slab	☒ Crawl Space
Trench Width	24", 8'oc	Max. Trench Bottom Depth	36"	Gravel Depth	NA		☐ GRAVITY	☒ PRESSURE		☐ Basement w/plumbing	☐ Basement w/o plumbing

Water Supply: ☒ Private ☐ Public ☐ Community

Comments / Conditions: ☆ Use filter in PT

8/1/13 Reviewed Floor plans, in Compliance with Original permit.
☆ Electrical checked, Alarm combined w/ bedroom and foyer breaker, pump on separate circuit

INITIAL SITE SKETCH

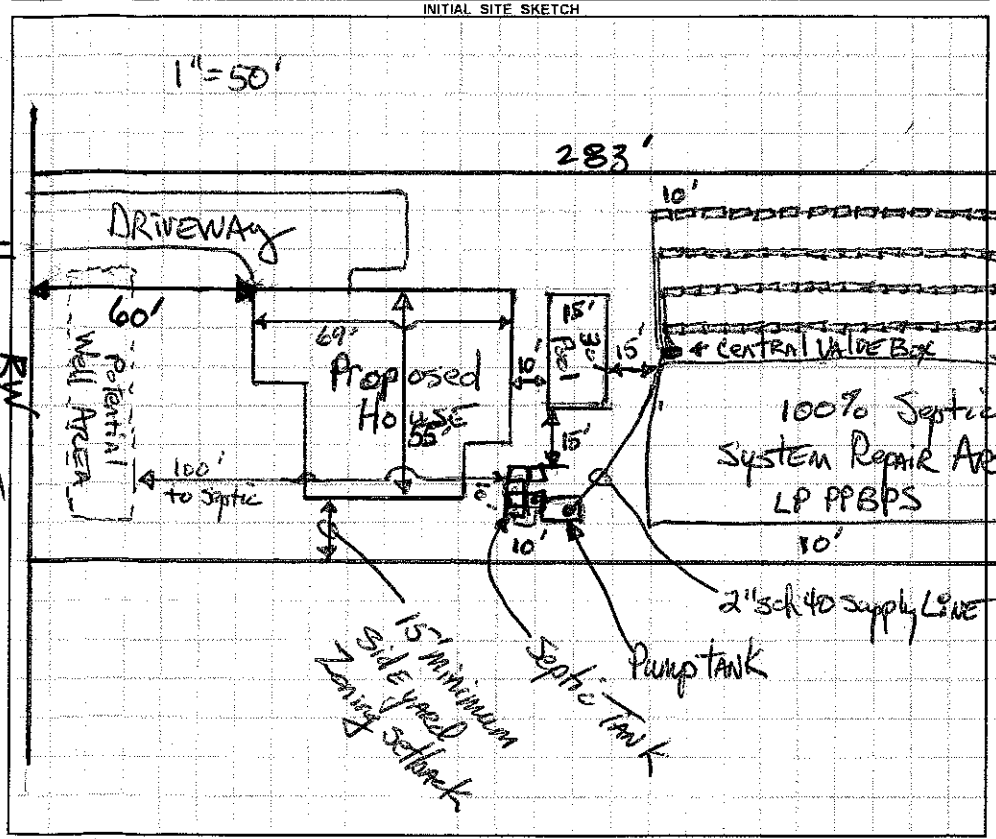


AS BUILT SKETCH

☆ Maintenance Contract Received 12-30-13

checked lines 12-19-13 measured 38.5' from deck to Line 1

AHP 12-30-13

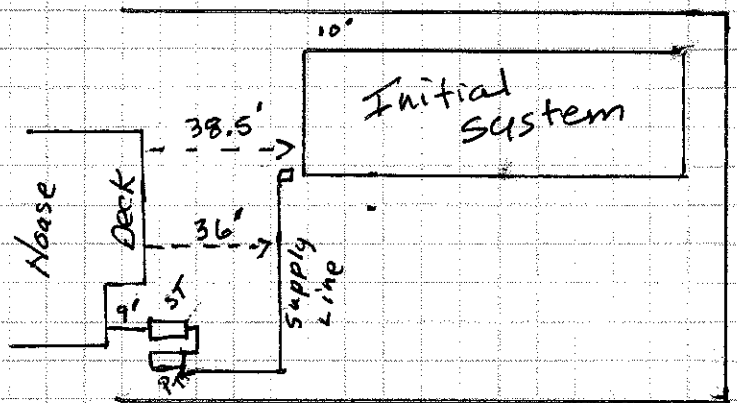

Permit can be suspended or revoked if any false information is supplied toward securing the permit / any unauthorized changes are made to the site / any unauthorized changes are made in the installation of the system. **CONTACT A LOCATOR SERVICE PRIOR TO ANY EXCAVATION**

☐ **IMPROVEMENT PERMIT** *with plat valid without expiration.* ☒ **IMPROVEMENT PERMIT** *with site plan valid for 60 mos.* ☐ **AUTHORIZATION TO CONSTRUCT** *valid for period equal to IMPROVEMENT PERMIT--not to exceed 60 mo.*

Owner / Applicant Signature: Date: Installed by: Specialty Septic

IMPROVEMENT PERMIT by: REHS Date: July 2, 2013 OPERATION PERMIT by: Date: 12-30-13

AUTHORIZATION TO CONSTRUCT by: RS Date: 8/1/13 Existing System Inspected by: Date:

Health Dept. Copy - WHITE Applicant (Final Approval) - YELLOW Applicant (Conditional Approval) - PINK