IREDELL COUNTY HEALTH DEPARTMENT

AUTHORIZATION TO CONSTRUCT (2.00)

STATESVILLE 704-878-5305 MOORESVILLE 704-664-5281

IMPROVEMENT PERMIT / ~~CERTIFICATE OF COMPLETION~~ / OPERATION PERMIT / EXISTING SYSTEM INSPECTION

PROPERTY DESCRIPTION NO. 066250 DATE 5/7/97 TAX MAP NO. 4645 18069 Watershed: ☑ Yes ☐ No

OWNER OR CONTRACTOR C. HOUSTON BALLARD PHONE: Business Home 278-2535

ADDRESS 4625 THIRD CREEK CHURCH RD CLEVELAND NC 27013

LOCATION 1155- TR LANDTREE - GO ACROSS I 77 - TL GUNDER LN. ON LT

SUBDIVISION — BLOCK / SECTION — LOT — LOT AREA ~1 AC SITE CLASS. RS DESIGN FLOW 360GPD L.T.A.R. .3 GPD/FT²

Septic Tank: 1000 Gallons; STB 794 Date 2/23/98

Pump Tank: ____ Gallons; PT ____ Date ____

Pump Make: ____ Model ____ Serial No. ____

Nitrification Field: No Fields 1 Square Feet 1200 Linear Feet 400

No Lines 5 @ 80' Trench Width 36" Max Trench Bottom Depth 36" Gravel Depth 12"

☑ New System ☐ Repair System Type: I, II, III, IV, V, VI

System Description: GRAVITY CONVENTIONAL

Repair System Description: CHAMBERED OR SIMILAR

Maintenance Agreement Required: ☐ Yes ☑ No

☑ House/Mod. Home No. Bedrooms 3

☐ Mobile Home No. Bathrooms 2

☐ Business No. Employees ____

☐ Other ____


☐ Slab ☑ Crawl Space ☐ Basement w/plumbing ☐ Basement wo/plumbing

Water Supply: ☑ Individual ☐ Community ☐ Public

Comments:

Comments:

INITIAL SITE SKETCH

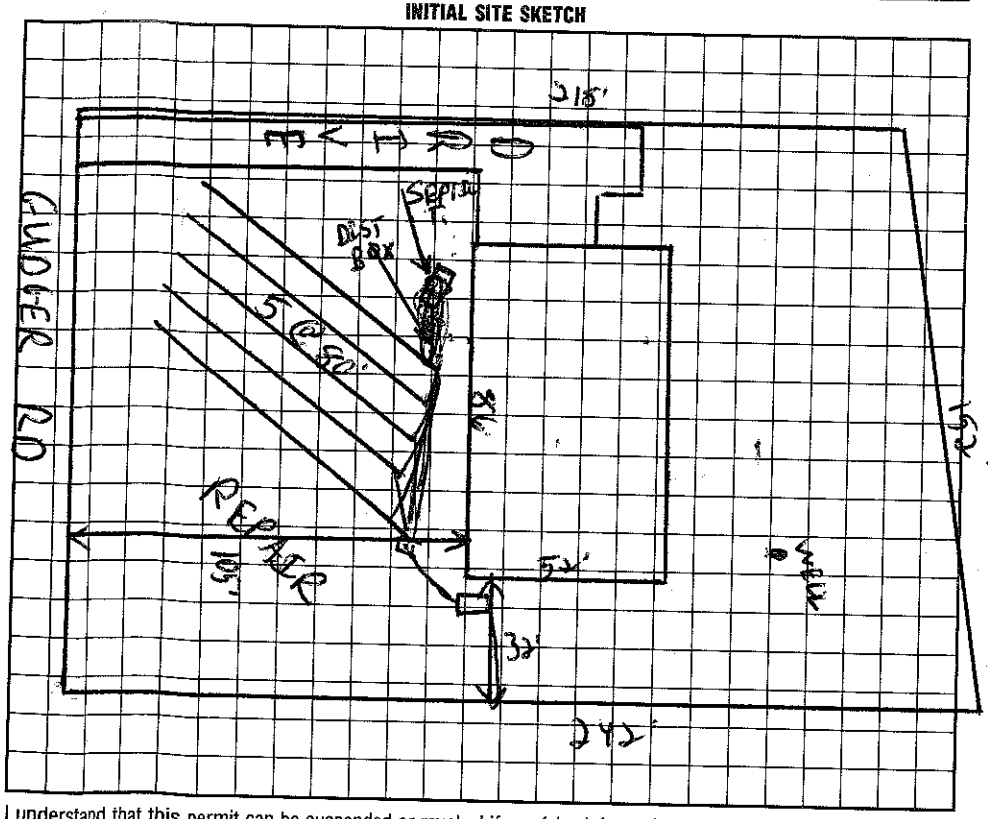

AS BUILT SKETCH

I understand that this permit can be suspended or revoked if any false information is supplied toward securing the permit/any unauthorized changes are made to the site/any unauthorized changes are made in the installation of the system. Improvement Permit is valid for 60 months from date of issuance.

Signed: C. Houston Ballard

Improvement Permit by: ____ date 5/7/97

~~Existing System Inspection by:~~ AUTHORIZATION TO CONSTRUCT ____ date 5/7/97

Installed by: ORBISON

Certificate of Completion by: ____ date ____

Operation Permit by: ____ date 3/27/98

HEALTH DEPT. COPY: WHITE INSPECTION COPY (FINAL): GREEN OWNER COPY (FINAL): YELLOW INSPECTION COPY (INITIAL): PINK OWNER COPY (INITIAL): GOLD