IREDELL COUNTY HEALTH DEPARTMENT

STATESVILLE 704-878-5305 MOORESVILLE 704-664-5281

IMPROVEMENT PERMIT / AUTHORIZATION TO CONSTRUCT / OPERATION PERMIT / EXISTING SYSTEM INSPECTION

(3:00)

PERMIT# 073643 PIN# 4645 22 2574

OWNER OR CONTRACTOR Tony Ball Patti Caldwell PHONE: Business DATE 6/18/98

ADDRESS 134 Yeoman Lane Mooresville NC. 28115 Home 892-4240

LOCATION Longtree TR Yeoman on (R) past 2nd house

SUBDIVISION YEOMAN SHORES BLOCK / SECTION 2 LOT 4 LOT AREA .49 Ac SITE CLASS. AS DESIGN FLOW 360 L.T.A.R. .3

Septic Tank: 1000 Gallons; STB 318 Date 7-1-00

Pump Tank: Gallons; PT Date

Pump Make: Model Serial No.

Nitrification Field; No Fields 1 Square Feet 900 Linear Feet 300 *

No Lines 4 Trench Width 36" Max Trench Bottom Depth 36" Gravel Depth SAND

☒ New System ☐ Repair System Type: I, II, (III) IV, V, VI

System Description: CH. PLASTIC F-Y Lay

Repair System Description: ~~SAME~~ Partial

Maintenance Agreement Required: ☐ Yes ☒ No

☐ House/Mod. Home No. Bedrooms 3

☐ Mobile Home No. Bathrooms 3

☐ Business No. Employees

☐ Other


☐ Slab ☐ Crawl Space ☐ Basement w/plumbing ☐ Basement wo/plumbing

Water Supply: ☒ Individual ☐ Public ☐ Community


Comments:/Conditions: * 25% reduction for ch Plastic drainfield

Comments:/Conditions: Filter a riser installed. Installed as Drawn * Deeded prior to 1983.

INITIAL SITE SKETCH

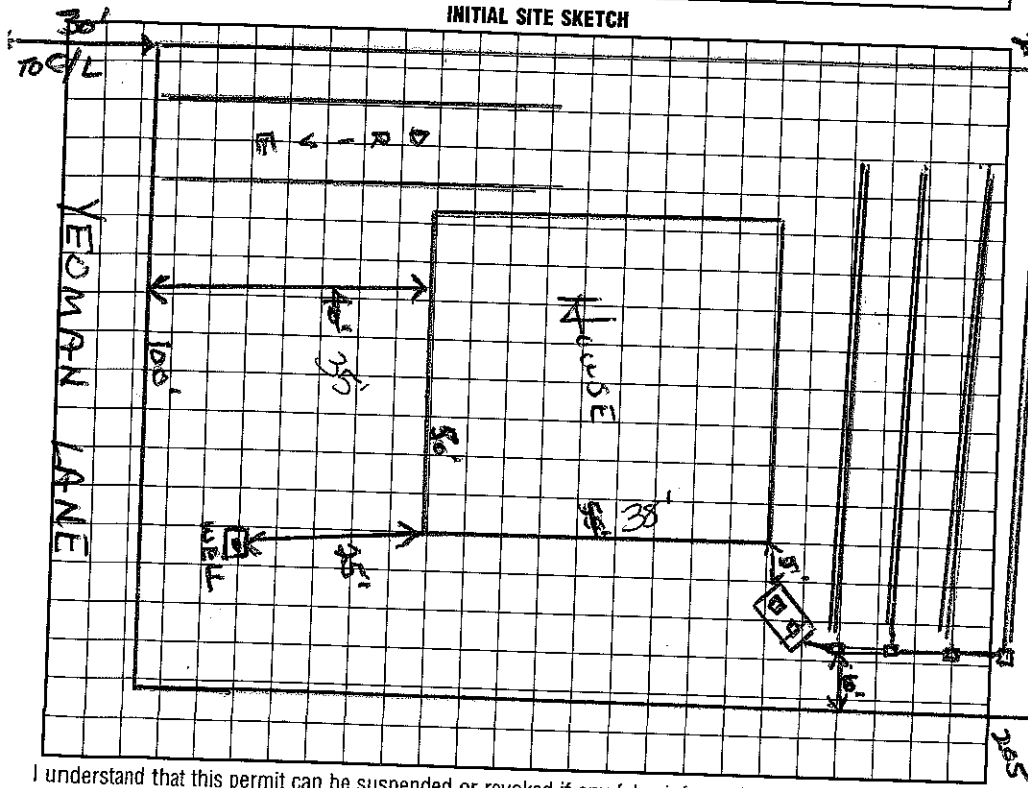

AS BUILT SKETCH

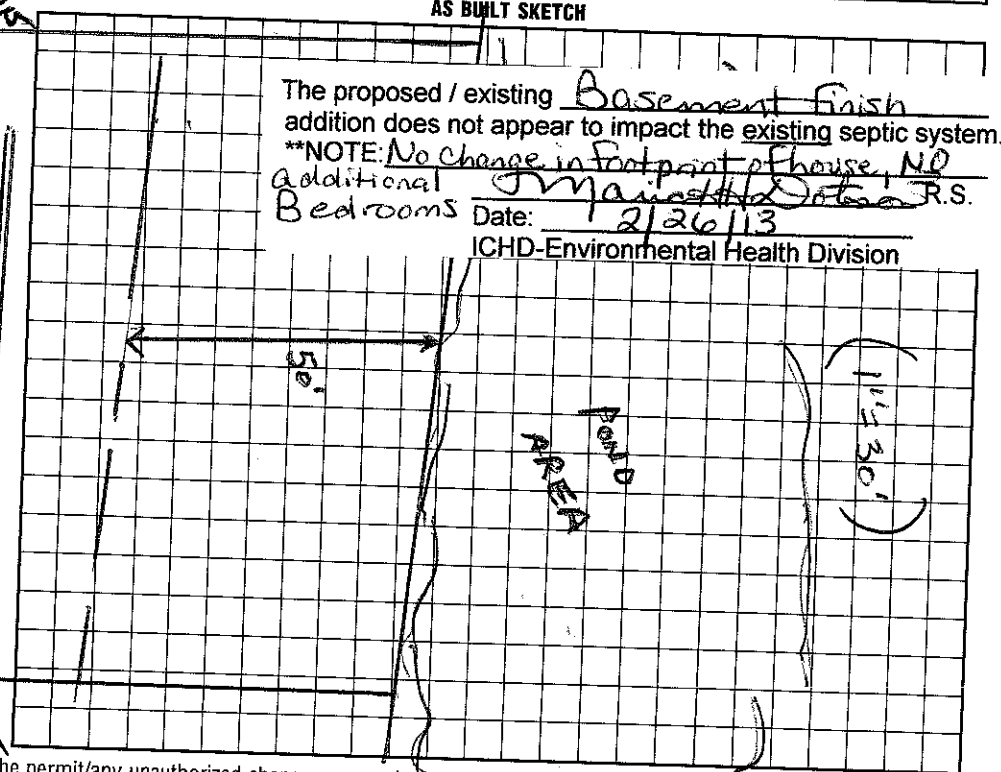

The proposed / existing Basement finish addition does not appear to impact the existing septic system.

**NOTE: No change in footprint of house, NO additional Bedrooms Date: 12/26/13 R.S.

ICHD-Environmental Health Division

I understand that this permit can be suspended or revoked if any false information is supplied toward securing the permit/any unauthorized changes are made to the site/any unauthorized changes are made in the installation of the system. Improvement Permit with plat valid without expiration. Improvement Permit with site plan valid for sixty months. Authorization to Construct is valid for a period equal to that of Improvement Permit – not to exceed sixty months.

Signed: * EOK w/Rita date 6/19/98

Improvement Permit by: Wesley Sparks R.S. date 6/18/98

Authorization to Construct by: Wesley Sparks R.S. date 6/18/98

Installed by: Curt Dunnagan R.S.

Operation Permit by: Maria H. Dotson date 8/11/2000

Existing System Inspection by: date

HEALTH DEPT. COPY: WHITE INSPECTION COPY (FINAL): GREEN OWNER COPY (FINAL): YELLOW INSPECTION COPY (INITIAL): PINK OWNER COPY (INITIAL): GOLD