IREDELL COUNTY HEALTH DEPARTMENT

ST[illegible]VILLE 704-878-5305 MOORESVILLE 704-664-5281

(1.30 - 2.00)

IMPROVEMENT PERMIT / AUTHORIZATION TO CONSTRUCT / OPERATION PERMIT / EXISTING SYSTEM INSPECTION

PERMIT# 073644 PIN# 4645 22 3399

OWNER OR CONTRACTOR Terry Ball PHONE: Business DATE 6/18/98

ADDRESS 134 Yeomon Lane Mooresville, NC. 28115 Home 892-4240

LOCATION Longtree TR Yeomon Lane on (R) before 2ND House

SUBDIVISION Yeomen Shores BLOCK / SECTION 2 LOT 6 LOT AREA .44Ac SITE CLASS. PS DESIGN FLOW 360 L.T.A.R. .3

Septic Tank: 1000 Gallons; STB 2117 Date 4/24/98

Pump Tank: Gallons; PT Date

Pump Make: Model Serial No.

Nitrification Field: No Fields 1 Square Feet 600 * Linear Feet 200 *

No Lines 4 Trench Width 36" Max Trench Bottom Depth 36" Gravel Depth STAND

[X] New System [ ] Repair System Type: I, II, (III) IV, V, VI

System Description: 16" PPBS

Repair System Description: Platted before 1983

Maintenance Agreement Required: [ ] Yes [X] No

[X] House/Mod. Home No. Bedrooms 3

[ ] Mobile Home No. Bathrooms 2

[ ] Business No. Employees

[ ] Other


[ ] Slab [X] Crawl Space [ ] Basement w/plumbing [ ] Basement wo/plumbing

Water Supply: [X] Individual [ ] Public [ ] Community


Comments:/Conditions: * 50% reduction for 16" PPBS

Comments:/Conditions:

INITIAL SITE SKETCH

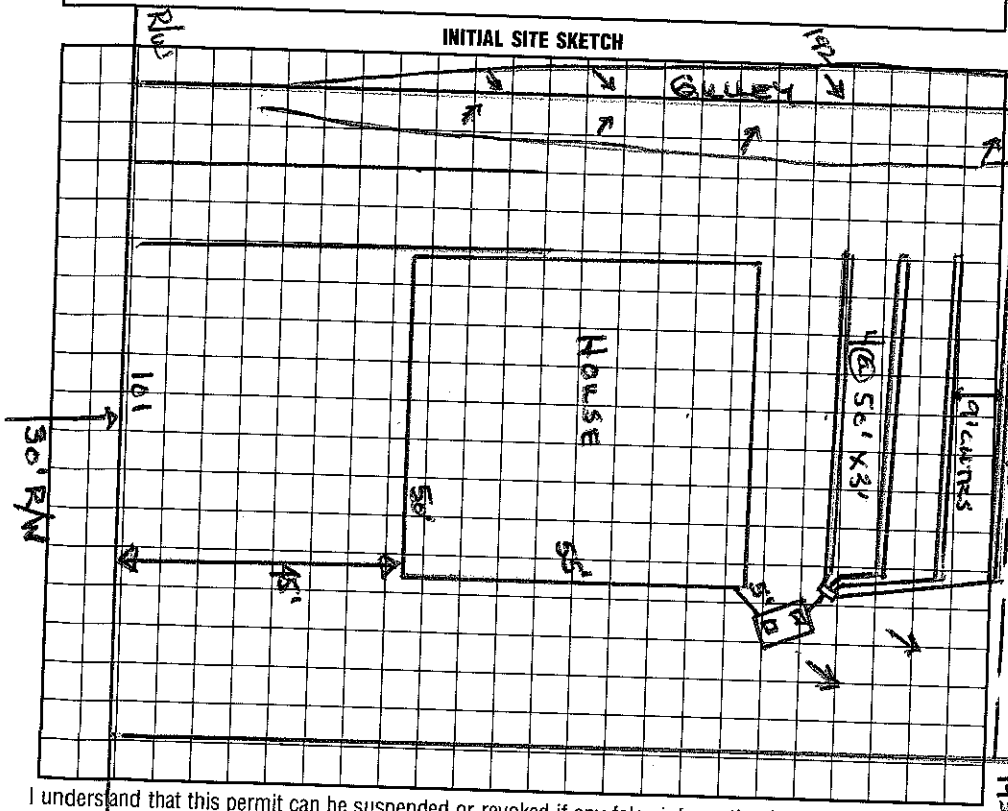

AS BUILT SKETCH

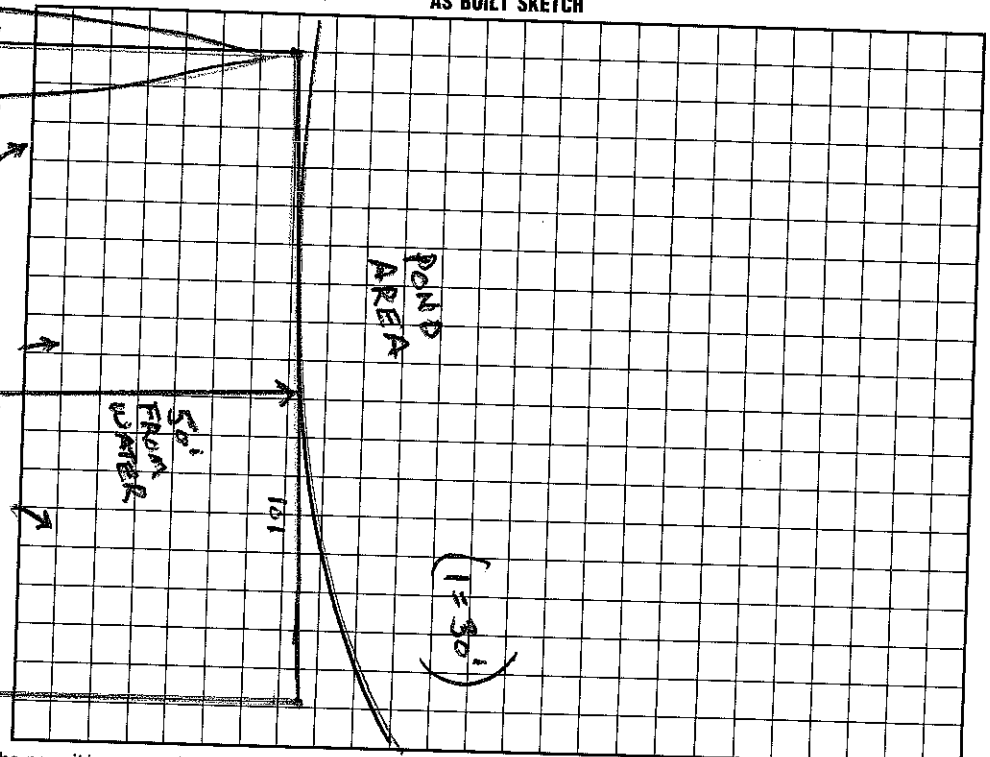

I understand that this permit can be suspended or revoked if any false information is supplied toward securing the permit/any unauthorized changes are made to the site/any unauthorized changes are made in the installation of the system. Improvement Permit with plat valid without expiration. Improvement Permit with site plan valid for sixty months. Authorization to Construct is valid for a period equal to that of Improvement Permit – not to exceed sixty months.

Signed: * [signature]

Improvement Permit by: Wesley Sparks RS. date 6/19/98

Authorization to Construct by: Wesley Sparks RS. date 6/18/98

Installed by: Curt Dunning Construction

Operation Permit by: [signature] date 5/21/99

Existing System Inspection by: date

HEALTH DEPT. COPY: WHITE INSPECTION COPY (FINAL): GREEN OWNER COPY (FINAL): YELLOW INSPECTION COPY (INITIAL): PINK OWNER COPY (INITIAL): GOLD