PIN# 4645-22-7807

IREDELL COUNTY HEALTH DEPARTMENT

STATESVILLE 704-878-5305 MOORESVILLE 704-664-5281

IMPROVEMENT PERMIT / CERTIFICATE OF COMPLETION / OPERATION PERMIT / EXISTING SYSTEM INSPECTION

PROPERTY DESCRIPTION NO. 18217 DATE May 4, '94 TAX MAP NO. 2A6A1 Watershed: ☑ Yes ☐ No LN

OWNER OR CONTRACTOR Leonard Leonelli PHONE: Business _____ Home 663-0090

ADDRESS Rt 9, Box 537, Mooresville

LOCATION 1102 TR into Carson's Place 1st lot on Left

SUBDIVISION CARSON'S PLACE BLOCK / SECTION _____ LOT 6 LOT AREA 210'x300' SITE CLASS: PS per 1956 DESIGN FLOW 480 gpd L.T.A.R. .03

Septic Tank: 1000 Gallons; STB 9994 Date 9/8/95

Pump Tank: _____ Gallons; PT _____ Date _____

Pump Make: _____ Model _____ Serial No. _____

Nitrification Field: No Fields 2 Square Feet _____ Linear Feet 270

No Lines 6 Trench Width 24" Max Trench Bottom Depth 36" Gravel Depth N/A

☑ New System ☐ Repair System Type: I, II, III, IV, V, VI

System Description: gravity PPBPS

Repair System Description: same

Maintenance Agreement Required: ☐ Yes ☑ No

☑ House/Mod. Home No. Bedrooms 4

☐ Mobile Home No. Bathrooms 3½

☐ Business No. Employees ____

☐ Other _____


☐ Slab ☑ Crawl Space ☐ Basement w/plumbing ☐ Basement wo/plumbing

Water Supply: ☑ Individual ☐ Community ☐ Public

Comments: Exit plumbing at grade where shown. Keep system shallow.

Comments:

INITIAL SITE SKETCH

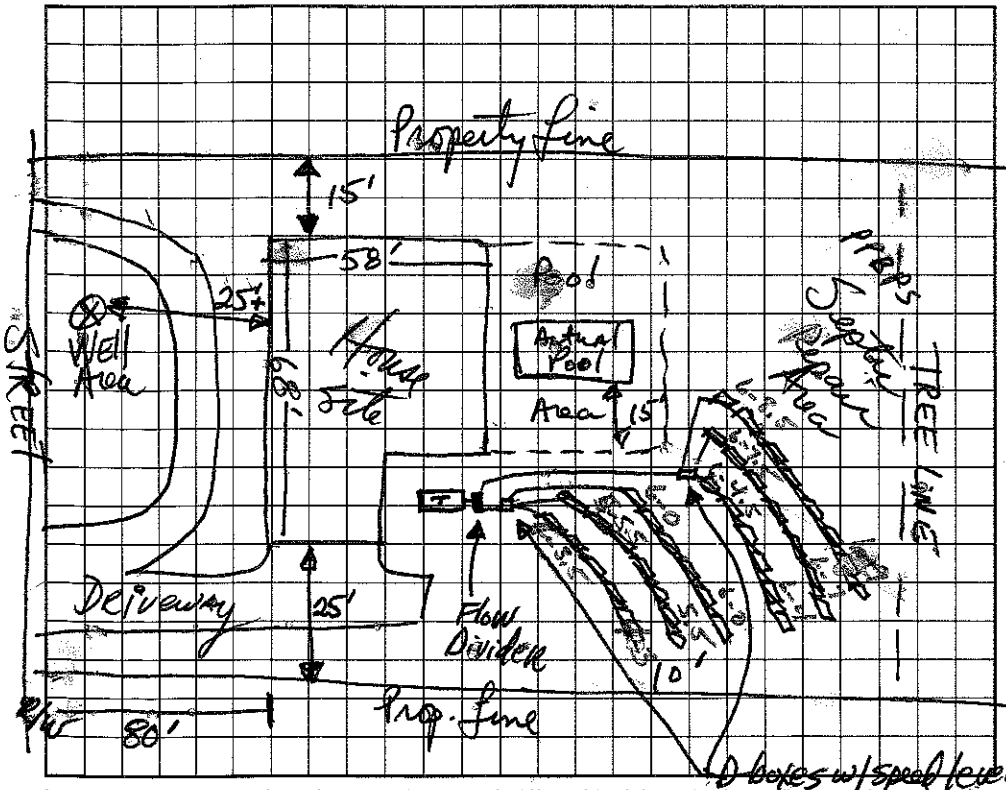

AS BUILT SKETCH

I understand that this permit can be suspended or revoked if any false information is supplied toward securing the permit/any unauthorized changes are made to the site/any unauthorized changes are made in the installation of the system. Improvement Permit is valid for 60 months from date of issuance.

Signed: X _____

Improvement Permit by: Paul R. Hinson, RS date 5/4/94

Existing System Inspection by: _____ date _____

Installed by: _____

Certificate of Completion by: _____ date _____

Operation Permit by: Wesley Sparks RS date 10/31/95

HEALTH DEPT. COPY: WHITE INSPECTION COPY (FINAL): GREEN OWNER COPY (FINAL): YELLOW INSPECTION COPY (INITIAL): PINK OWNER COPY (INITIAL): GOLD