PIN# 4645-22-7918

# IREDELL COUNTY HEALTH DEPARTMENT

STATESVILLE 704-878-5305 MOORESVILLE 704-664-5281

## IMPROVEMENT PERMIT / CERTIFICATE OF COMPLETION / OPERATION PERMIT / EXISTING SYSTEM INSPECTION

PROPERTY DESCRIPTION NO. 20510 DATE 3-15-95 TAX MAP NO. 2A-6-A-7 Watershed: ☑ Yes ☐ No

OWNER OR CONTRACTOR Glenda C. Watson PHONE: Business _____ Home (704-364-1179) WS IV CA

ADDRESS 120 Hillandale Dr. Charlotte N.C. 28270

LOCATION @ 115 South TR Evanstree TR Carson's Place on left

SUBDIVISION Carson's Place BLOCK / SECTION _____ LOT 7 LOT AREA 106X308 SITE CLASS. PS DESIGN FLOW ~~440~~ L.T.A.R. .35

Septic Tank: 1000 Gallons; STB 794 Date 9/30/96

Pump Tank: _____ Gallons; PT _____ Date _____

Pump Make: _____ Model _____ Serial No. _____

Nitrification Field: No. Fields 1 Square Feet 1380 Linear Feet 460

No. Lines 4 Trench Width 36" Max Trench Bottom Depth 36" Gravel Depth 12"

☑ New System ☐ Repair System Type: I, ☑ II, III, IV, V, VI

System Description: Conv. Gravity

Repair System Description: Gravity Infiltrator

Maintenance Agreement Required: ☐ Yes ☑ No

☑ House/Mod. Home ☐ Mobile Home ☐ Business ☐ Other

No. Bedrooms 4 No. Bathrooms 2½ No. Employees _____


☐ Slab ☑ Crawl Space ☐ Basement w/plumbing ☐ Basement wo/plumbing

Water Supply: ☑ Individual ☐ Community ☐ Public

Comments:

Comments:

**INITIAL SITE SKETCH**

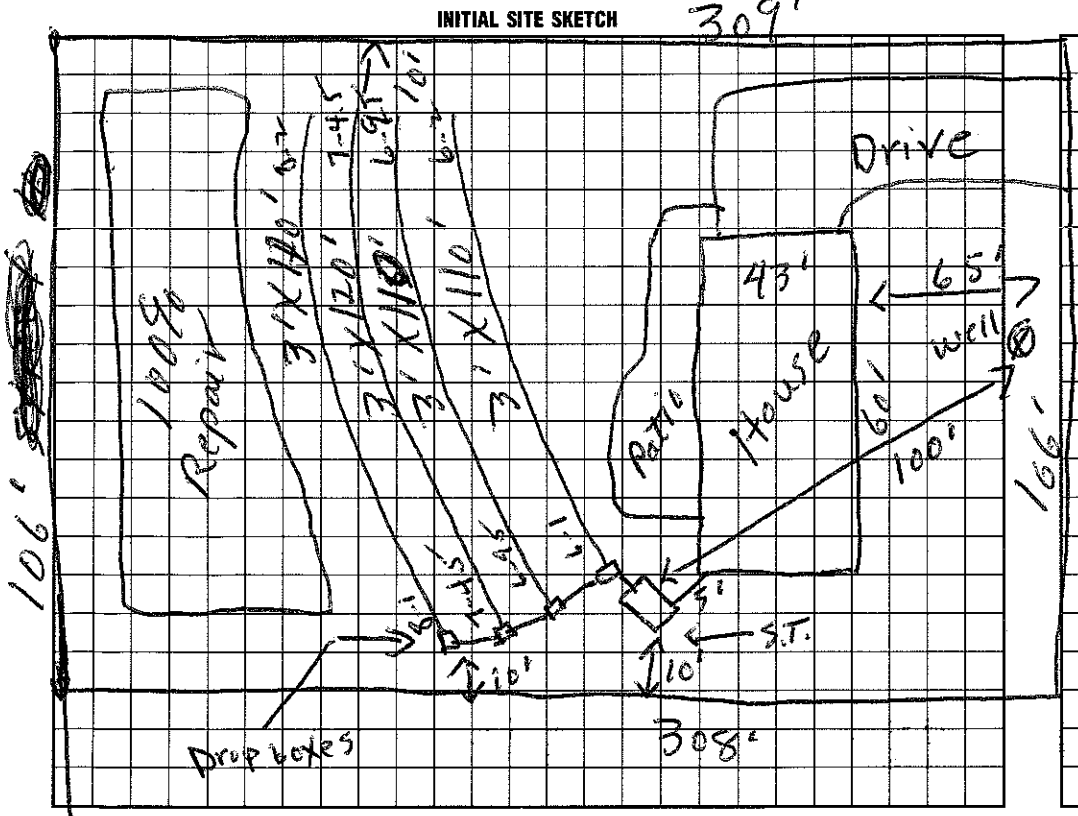


**AS BUILT SKETCH**

I understand that this permit can be suspended or revoked if any false information is supplied toward securing the permit/any unauthorized changes are made to the site/any unauthorized changes are made in the installation of the system. Improvement Permit is valid for 60 months from date of issuance.

Signed: x Glenda C. Watson

Improvement Permit by: J. C. Moore date 3-15-95

Existing System Inspection by: _____ date _____

Installed by: F J Ervin

Certificate of Completion by: _____ date _____

Operation Permit by: Wesley Sparks R.S. date 2/20/97

HEALTH DEPT. COPY: WHITE INSPECTION COPY (FINAL): GREEN OWNER COPY (FINAL): YELLOW INSPECTION COPY (INITIAL): PINK OWNER COPY (INITIAL): GOLD