IREDELL COUNTY HEALTH DEPARTMENT

PIN#464 130.00 Paid 2100

STATESVILLE 704-878-5305 MOORESVILLE 704-664-5281

IMPROVEMENT PERMIT / AUTHORIZATION TO CONSTRUCT / OPERATION PERMIT / EXISTING SYSTEM INSPEC

PERMIT# 108965 PIN# 4645229312 Pete Tuffo DATE 10/11/200

OWNER OR CONTRACTOR Jeff & Katherine Opal PHONE: Business (704) 987-8628 Home 704 905-5375

ADDRESS 8803 Samara Court Charlotte, NC 28269

LOCATION Hwy 115 South TR Langtree TR Carson's Place TR 1st Cul-de-Sac Turnerlair

SUBDIVISION Carson's Place BLOCK / SECTION ____ LOT 1 LOT AREA .787 Acre SITE CLASS. PS DESIGN FLOW 480 gpd L.T.A.R. .25 - .3

Septic Tank: 1000 Gallons; STB 794 Date 7-1-03

Pump Tank: ____ Gallons; PT ____ Date ____

Pump Make: ____ Model ____ Serial No. ____

Nitrification Field: No Fields 1 Square Feet 1440 Linear Feet 480'

No Lines 7 Trench Width 36" Max Trench Bottom Depth 36" + Gravel Depth N/A

X New System ☐ Repair System Type: I, II, III, IV, V, VI

System Description: Gravity-25% Reduction

Repair System Description: Pump-LP-Panel Blk

Maintenance Agreement Required: ☐ Yes X No Not Initially

X House/Mod. Home No. Bedrooms 4

☐ Mobile Home No. Bathrooms 3½

☐ Business No. Employees ____

☐ Other ____


☐ Slab ☐ Crawl Space X Basement w/plumbing ☐ Basement wo/plumbing

Water Supply: X Individual ☐ Public ☐ Community

Comments/Conditions: Keep Septic System at least 25' from basement wall, 10' from PL & at least 50' from any well

Comments/Conditions: Okay to remove old berms in upper Drainfield area. Do Not grade in ST area.
Note: Builder is using "Separate Sewage pump/grinder pump for basement"

INITIAL SITE SKETCH Scale 1:50

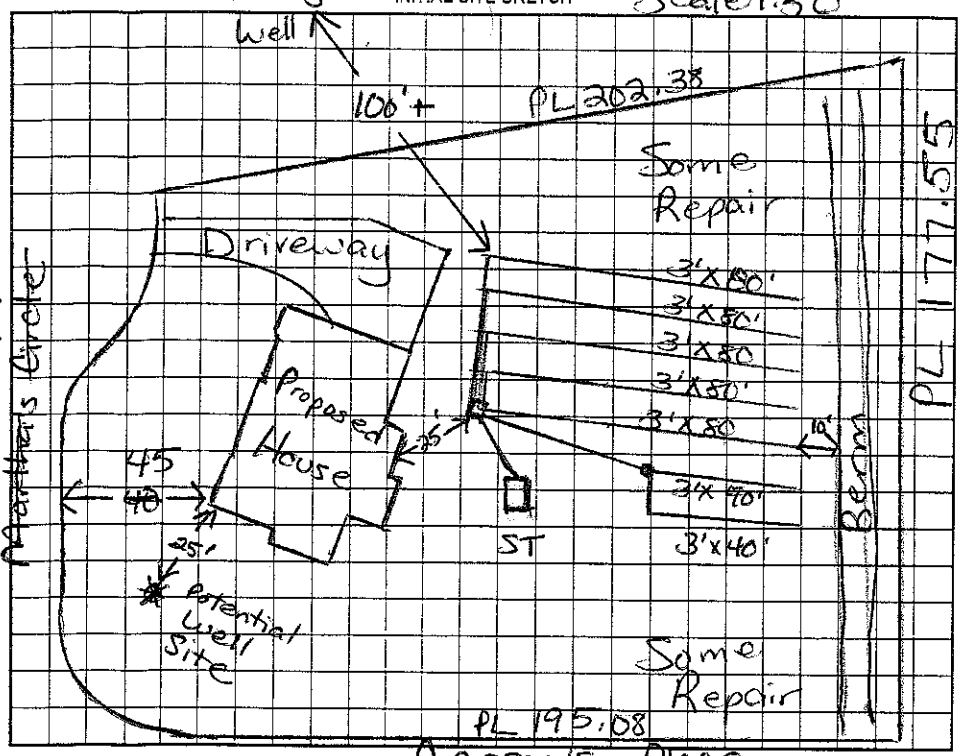

AS BUILT SKETCH

X Polylok Filter installed

Installed "Plastic Chambers" For Drainfield

Nice job on installation

Permit can be suspended or revoked if any false information is supplied toward securing the permit/any unauthorized changes are made to the site/any unauthorized changes are made in the installation of the system. Improvement Permit with plat valid without expiration. Improvement Permit with site plan valid for sixty months. Authorization to Construct is valid for a period equal to that of Improvement Permit – not to exceed sixty months.

Signed: X Pete Tuffo 10/16/02 date ____

Improvement Permit by: Maria H. Dobson RS date 10/11/02

Authorization to Construct by: Maria H. Dobson RS date 10/11/02

Installed by: Richard Abernathy

Operation Permit by: Maria H. Dobson RS date 10/6/03

Existing System Inspection by: ____ date ____

HEALTH DEPT. COPY: WHITE OWNER COPY (FINAL): YELLOW OWNER COPY (INITIAL): PINK