IREDELL COUNTY HEALTH DEPARTMENT

STATESVILLE 704-878-5305 MOORESVILLE 704-664-5281

IMPROVEMENT PERMIT / AUTHORIZATION TO CONSTRUCT / OPERATION PERMIT / EXISTING SYSTEM INSPECTION

PERMIT# 081714 PIN# 4645231696 DATE 6/30/99

OWNER OR CONTRACTOR Tim & Kathleen Shook PHONE: Business Home 895-3241

ADDRESS 151 Bain Ln Mooresville NC 28117

LOCATION Langtree TR Yeoman TR Bain House on left near end

SUBDIVISION Yeoman Shores BLOCK / SECTION LOT 6 LOT AREA SITE CLASS. DESIGN FLOW 360gpd T.A.R. Existing

Septic Tank: Existing Gallons; STB Date

Pump Tank: Gallons; PT Date

Pump Make: Model Serial No.

Nitrification Field: No Fields 1 Square Feet 600' Linear Feet 200'

No Lines 3 Trench Width 9' Max Trench Bottom Depth Gravel Depth 12"

☒ New System ☐ Repair System Type: I, II, III, IV, V, VI

System Description: Existing Gravity-Convent

Repair System Description:

Maintenance Agreement Required: ☐ Yes ☐ No

☒ House/Mod. Home No. Bedrooms 3 (3 office)

☐ Mobile Home No. Bathrooms 3

☐ Business No. Employees

☐ Other

☐ Slab ☐ Crawl Space ☒ Basement w/plumbing ☐ Basement wo/plumbing


Water Supply: ☒ Individual ☐ Public ☐ Community

Comments/Conditions: Existing Septic System appears to be functioning okay; No problems Noticed


Keep all additions at least 5' from septic

Comments/Conditions: Upgrade/Addition to House Drainfield sized okay for 3 Bedroom + office

INITIAL SITE SKETCH

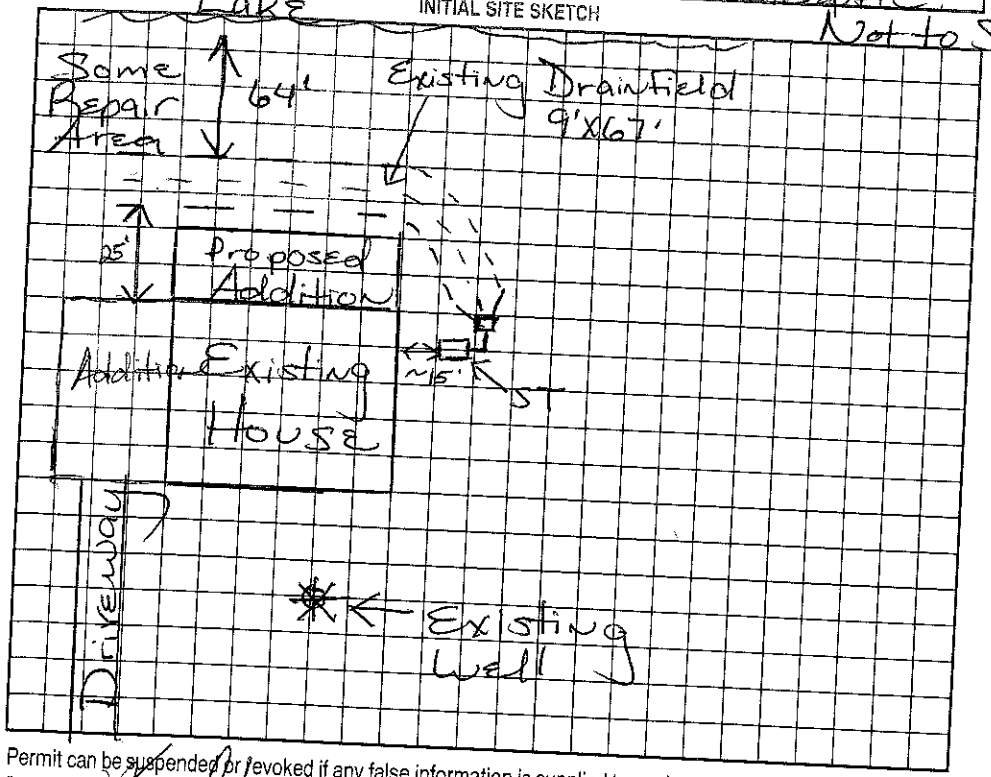

AS BUILT SKETCH

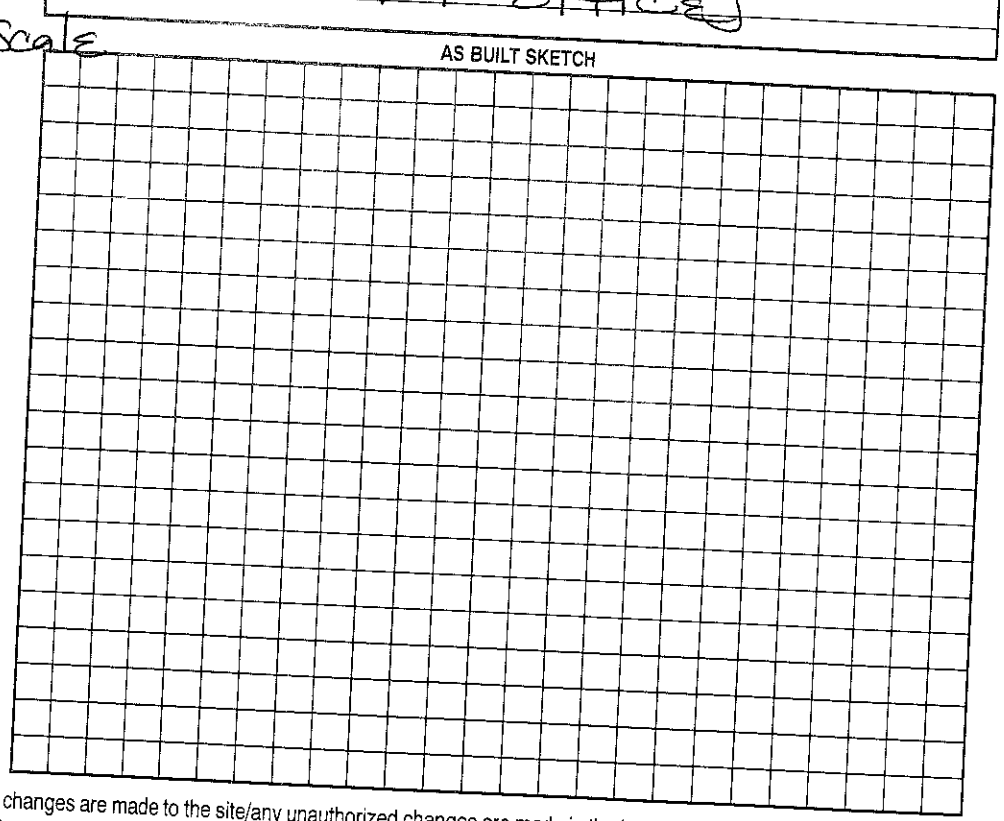

Permit can be suspended or revoked if any false information is supplied toward securing the permit/any unauthorized changes are made to the site/any unauthorized changes are made in the installation of the system. Improvement Permit with plat valid without expiration. Improvement Permit with site plan valid for sixty months. Authorization to Construct is valid for a period equal to that of Improvement Permit – not to exceed sixty months.

Signed: X [signature]

Improvement Permit by: Maria H H Dotson RS date 6/30/99 Installed by:

Authorization to Construct by: Maria H H Dotson date 6/30/99 Operation Permit by: date

Existing System Inspection by: Maria H H Dotson date 6/30/99

HEALTH DEPT. COPY: WHITE OWNER COPY (FINAL): YELLOW OWNER COPY (INITIAL): PINK