IREDELL COUNTY HEALTH DEPARTMENT 4645232403

Statesville Phone TR 3-7271 Mooresville Phone No. 664-5281

PERMIT TO INSTALL SEPTIC TANK

Permit No. 129 Permit Date 6-15- 1973

Owner Stop + Shop of Concord Inc. Address Concord

Installed By Mauldin Septic Tank Co. Address Concord

Location of Property 1102 TR on 1202 Stay right 1/4 mi on left.


139 Bain Lake - Yeoman Shores S3 Lot 4

Tank		Capacity		Length of Lines		max Fixtures	
Block	( )	1000	( )	225'	( )	No. of Baths	(3)
Precast	(✓)	1250	( )	250'	( )	Dishwasher	(yes
		1500	(✓)	Other 240'		Garbage Grdr.	(yes
		Other				Other washing machin

NOTIFY HEALTH DEPARTMENT AT LEAST EIGHT HOURS BEFORE TANK IS TO BE INSPECTED.

Final Inspection 6-15- 1973 Approved (✓) Disapproved ( )

Remarks

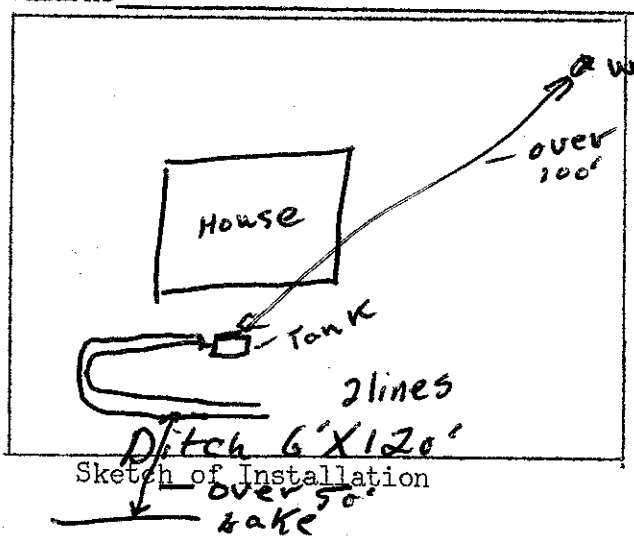

Sketch of Installation

J. C. Moore

Sanitarian