IREDELL COUNTY HEALTH DEPARTMENT

IMPROVEMENT PERMIT / CERTIFICATE OF COMPLETION / OPERATION PERMIT / EXISTING SYSTEM INSPECTION

STATESVILLE 704-878-5305 MOORESVILLE 704-664-5281

4645234577

PROPERTY DESCRIPTION NO. 17485 DATE Dec 23, '93

OWNER OR CONTRACTOR Broadmoore Homes TAX MAP NO. 2612 C11

ADDRESS PO Box 1242 Mooresville PHONE: Business 663-7660 Home

LOCATION 1102 TR Yeoman Lane TR Bain Lane on Right near end Watershed: ☑ Yes ☐ No L.N.

SUBDIVISION Yeoman Shores BLOCK / SECTION LOT 11 LOT AREA 101'X230' SITE CLASS PS DESIGN FLOW 360 gpd L.T.A.R. .3 gal/ft²/day

Septic Tank: 1000 Gallons; STB 825 RST Date 3-17-94

Pump Tank: Gallons; PT Date

Pump Make: Model Serial No.

Nitrification Field: No Fields 2 Square Feet 1200 Linear Feet 400

No Lines 3+3 Trench Width 36" Max Trench Bottom Depth 36"

☑ New System ☐ Repair System Type: I, II, III, IV, V, VI

System Description: gravity conventional

Repair System Description gravity PPBPS

Maintenance Agreement Required: ☐ Yes ☑ No

Gravel Depth 12"

☐ House/Mod. Home ☐ Mobile Home ☐ Business ☐ Other

No. Bedrooms 3 No. Bathrooms 2 No. Employees


☐ Slab ☑ Crawl Space ☐ Basement w/plumbing ☐ Basement wo/plumbing

Water Supply: ☑ Individual ☐ Community ☐ Public


Comments: 3/17/94 Septic system installer asked for option of using drop boxes instead of flow dividers & 4 taps, I okayed this as being an acceptable option although I still prefer the way it's shown on sketch. RDH

Comments:

INITIAL SITE SKETCH

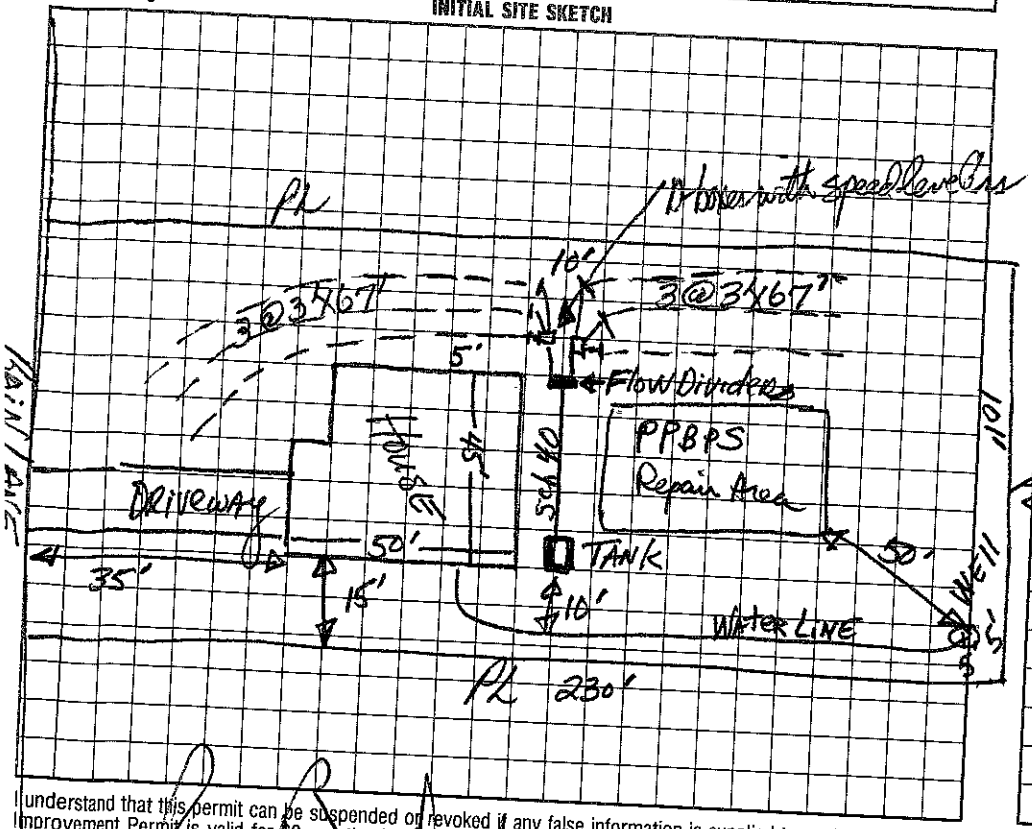

AS BUILT SKETCH

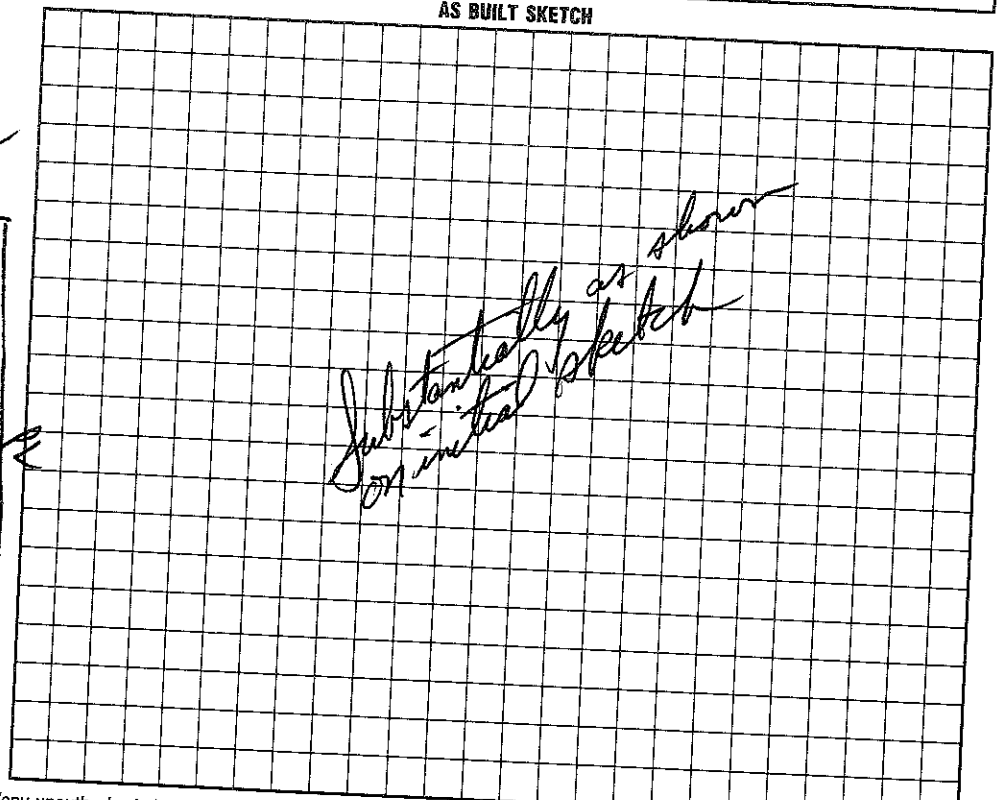

I understand that this permit can be suspended or revoked if any false information is supplied toward securing the permit/any unauthorized changes are made to the site/any unauthorized changes are made in the installation of the system. Improvement Permit is valid for 60 months from date of issuance.

Signed: X

Improvement Permit by: Jack R. Hinson, RS date 12/23/93 Jan 24 '94

Existing System Inspection by: date

Installed by: Curt Deaning

Certificate of Completion by: Jack R. Hinson RS date 5/20/94

Operation Permit by: date

HEALTH DEPT. COPY: WHITE INSPECTION COPY (FINAL): GREEN OWNER COPY (FINAL): YELLOW INSPECTION COPY (INITIAL): PINK OWNER COPY (INITIAL): GOLD