IREDELL COUNTY HEALTH DEPARTMENT

STATESVILLE 70[illegible]5305 MOORESVILLE 704-664-5281

IMPROVEMENT PERMIT / AUTHORIZATION TO CONSTRUCT / OPERATION PERMIT / EXISTING SYSTEM INSPECTION

PERMIT # 156798 PIN # 4645 23 4687 DATE 8/4/09

OWNER or APPLICANT MAUREEN ROBERGE PHONE: Business 704-323-9222 Home:

OWNER or APPLICANT ADDRESS 154 BAIN LN. MOORESVILLE, NC 28117

LOCATION / DIRECTIONS I-55 TR LANGTREE X 77 TR YEOMAN LN. TR BAIN LN ON (R) OFF CUL DE SAC

SUBDIVISION YEOMAN SHORES BLOCK / SECTION LOT # 10 LOT AREA .496 DESIGN FLOW 360 L.T.A.R. .3

Septic Tank EXISTING Gallons: STB Date

Pump Tank Gallons: P T Date

Pump Make Model Serial #

Nitrification Field No Fields 1 No Lines 1 Linear Feet 100

Trench Width 3' Max. Trench Bottom Depth 3' Gravel Depth NO

☐ New System ☒ Repair ☐ Expansion System Type I II III IV V VI

System Description:

Repair System Description: 25% REDUCTION W STEP DOWN

Maintenance Agreement Required ☐ YES ☒ NO

☒ GRAVITY ☐ PRESSURE

☒ Residence No. Bedrooms 3

☐ Business No. Persons

☐ Other No. Employees

☐ Slab ☐ Crawl Space


☒ Basement w/plumbing ☐ Basement w/o plumbing

Water Supply: ☒ Private ☐ Public ☐ Community

Comments / Conditions

Comments / Conditions NEW D/B W SPEED LEVELERS - BALANCED AT FINAL INSPECTION — REPAIR LINE 100'x3' EQUIP INSTALLED AS SHOWN

INITIAL SITE SKETCH

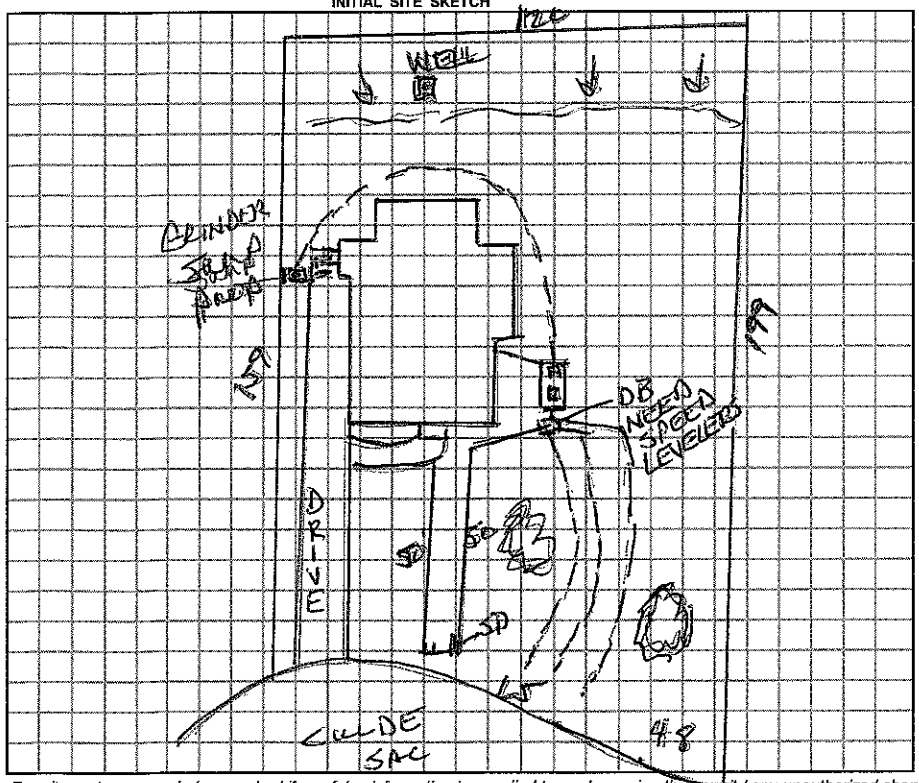

AS BUILT SKETCH

Permit can be suspended or revoked if any false information is supplied toward securing the permit, any unauthorized changes are made to the site / any unauthorized changes are made in the installation of the system.

☐ *IMPROVEMENT PERMIT w / plat valid without expiration.* ☐ *IMPROVEMENT PERMIT w / site plan valid for 60 mos.* ☒ *AUTHORIZATION TO CONSTRUCT valid for period equal to IMPROVEMENT PERMIT-not to exceed 60 mo.*

Owner / Applicant Signature: X OK BAIN LN. Date 8/5/09

Improvement Permit by: Wesley Sparks RS Date 8/4/09

Authorzation to Construct by: Wesley Sparks RS Date 8/4/09

YOU SHOULD CONTACT A LOCATOR SERVICE PRIOR TO ANY EXCAVATION.

Installed by: Gary Johnson

Operation Permit by: Wesley Sparks RS. Date: 8/27/09

Existing System Inspected by: Date:

WHITE COPY Environmental Health YELLOW COPY (Final) Owner / Applicant PINK COPY (Initial) Owner / Applicant

PAGE 01/01

...ELL COUNTY HEALTH DEPARTMENT

...OVILLE 704-878-5305 MOORESVILLE 704-664-5281

IMPROVEMENT PERMIT / CERTIFICATE OF COMP... TION / OPERATION PERMIT / EXISTING SYSTEM INSPECTION

PROPERTY DESCRIPTION NO. 16130 DATE July 28 1993 TAX MAP NO. 2G-12-6 C-10

OWNER OR CONTRACTOR ANGELA BAILEY PHONE: Business Home 704-523-4749

ADDRESS 5511 VALLEY FORGE ROAD CHARLOTTE NC 28210

LOCATION AT END OF BAIN LANE ON RIGHT/LANGTREE RD W/OF I-77 TO YOEMAN LANE, RT, THEN RT ON BAIN LANE

SUBDIVISION YOEMAN SUBDS BLOCK / SECTION LOT 10 LOT AREA SITE CLASS. P L.T.A.R. .03

Water Supply: ☑ Individual ☐ Community ☐ Public

Septic Tank: 1500 1000 Gallons; STB 97-145 Lancaster SC Date 7-27-93

Pump Tank: Gallons; PT Date

Nitrification Field: No Fields 1 Square Feet 801 Linear Feet 267

No Lines 4 DR. Trench Width 36" Trench Depth 24" Gravel Depth 12"

☑ New System ☐ Repair System Type: I, II, IV, V, VI

System Description: GRAVITY CONVENTIONAL

Repair System Description: PUMP PPBPS

Maintenance Agreement Required: ☐ Yes ☐ No

☑ House/Mod. Home ☐ Mobile Home ☐ Business ☐ Other

No. Bedrooms 2 No. Bathrooms 2 No. Employees

☑ Slab ☑ Crawl Space ☐ Basement w/plumbing ☐ Basement w/o plumbing

Garbage Disposal: ☑ Yes ☐ No


Auto. Dishwasher: ☑ Yes ☐ No


Auto. Washing Machine: ☑ Yes ☐ No

Other

Comments DO NOT INSTALL DURING WET SOIL CONDITIONS, DO NOT GRADE FILL OR TRAFFIC OVER NITRIFICATION FIELD AREA. WELL SETBACKS-50' FROM SEPTIC SYSTEMS 25' FROM BLDG FOUNDATIONS, 10' FROM PROPERTY LINES. DIVERT SURFACE WATER + ROOF WATER RUNOFF AWAY FROM SYSTEM, TO REAR OF LOT. ALTERNATE LAYOUT POSSIBLE-

INITIAL SITE SKETCH

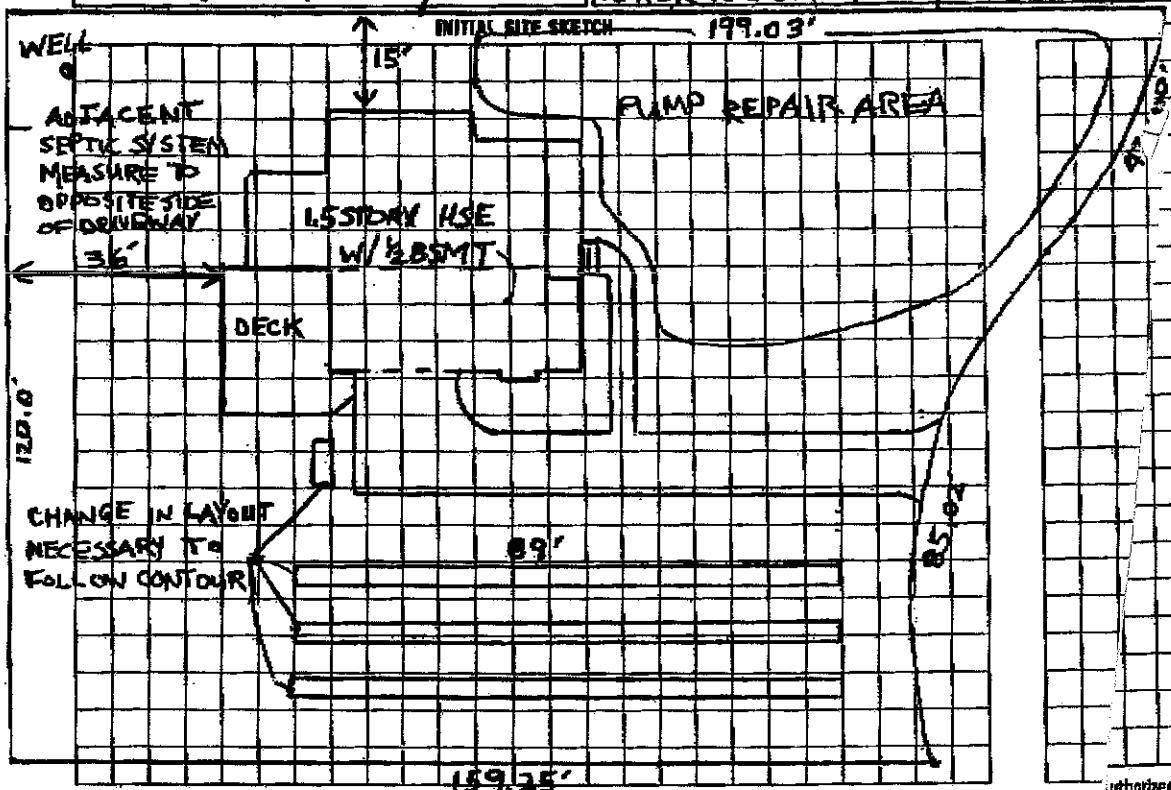

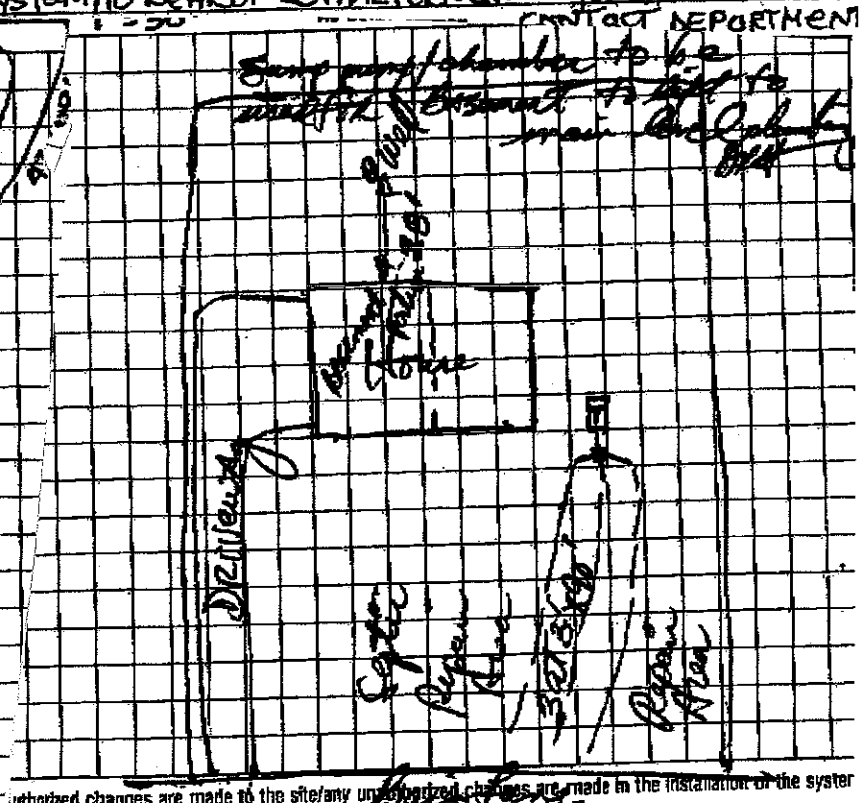

I understand that this permit can be suspended or revoked if any false information is supplied toward securing the permit/any unauthorized changes are made to the site/any unauthorized changes are made in the installation of the syster

Improvement Permit is valid for 60 months from date of issuance.

Signed: [illegible], Agent

Improvement Permit by: Andrea Lemon date 7-28-93

Existing System Inspection by: date

Installed by: WT Maynard Bx 99, Waxhaw, NC 28173

Certificate of Completion by: [illegible], RS date 10/18/93

Operation Permit by: date

HEALTH DEPT. COPY: WHITE INSPECTION COPY (FINAL): GREEN OWNER COPY (FINAL): YELLOW INSPECTION COPY (INITIAL): PINK OWNER COPY (INITIAL): GOLD

05/25/2009 02:22 704-6649737