IREDELL COUNTY HEALTH DEPARTMENT

IMPROVEMENT PERMIT / CERTIFICATE OF COMPLETION / OPERATION PERMIT / EXISTING SYSTEM INSPECTION

...SVILLE 704-878-5305 MOORESVILLE 704-664-5281

PROPERTY DESCRIPTION NO. 16130

OWNER OR CONTRACTOR ANGELA BAILEY DATE July 28 1993

ADDRESS 5511 VALLEY FORGE ROAD CHARLOTTE NC 28210 PHONE: Business 4649234687 TAX MAP NO. 2G-12-E C-10

LOCATION AT END OF BAIN LANE ON RIGHT/LANGTREE RD W/OF I-77 TO YOEMAN LANE RT, THEN RT ON BAIN LANE Home 704-523-4749

SUBDIVISION YOEMAN SHORES BLOCK / SECTION LOT 10 LOT AREA SITE CLASS. P L.T.A.R. 0.3

Water Supply: ☑ Individual ☐ Community ☐ Public

Septic Tank: ~~1500~~ 1000 Gallons; STB 97-345 LANCASTER SC Date 7-27-93

Pump Tank: Gallons; PT Date

Nitrification Field: No Fields 1 Square Feet 801 Linear Feet 267

No Lines VAR. Trench Width 36" Trench Depth 24" Gravel Depth 12"

☑ New System ☐ Repair System Type: I, II, IV, V, VI

System Description: GRAVITY CONVENTIONAL

Repair System Description: PUMP PPBPS

Maintenance Agreement Required: ☐ Yes ☐ No

☑ House/Mod. Home ☐ Mobile Home ☐ Business ☐ Other

No. Bedrooms 2 No. Bathrooms 2 No. Employees

☑ Slab ☑ Crawl Space ☐ Basement w/plumbing ☐ Basement wo/plumbing

Garbage Disposal: ☑ Yes ☐ No


Auto. Dishwasher: ☑ Yes ☐ No

Auto. Washing Machine: ☑ Yes ☐ No


Other

Comments DO NOT INSTALL DURING WET SOIL CONDITIONS. DO NOT GRADE FILL OR TRAFFIC OVER NITRIFICATION FIELD AREA. WELL SETBACKS-50' FROM SEPTIC SYSTEMS 25' FROM BLDG FOUNDATIONS, 10' FROM PROPERTY LINES. DIVERT SURFACE WATER + ROOF WATER RUNOFF AWAY FROM SYSTEM, TO REAR OF LOT. ALTERNATE LAYOUT POSSIBLE - CONTACT DEPARTMENT.

INITIAL SITE SKETCH

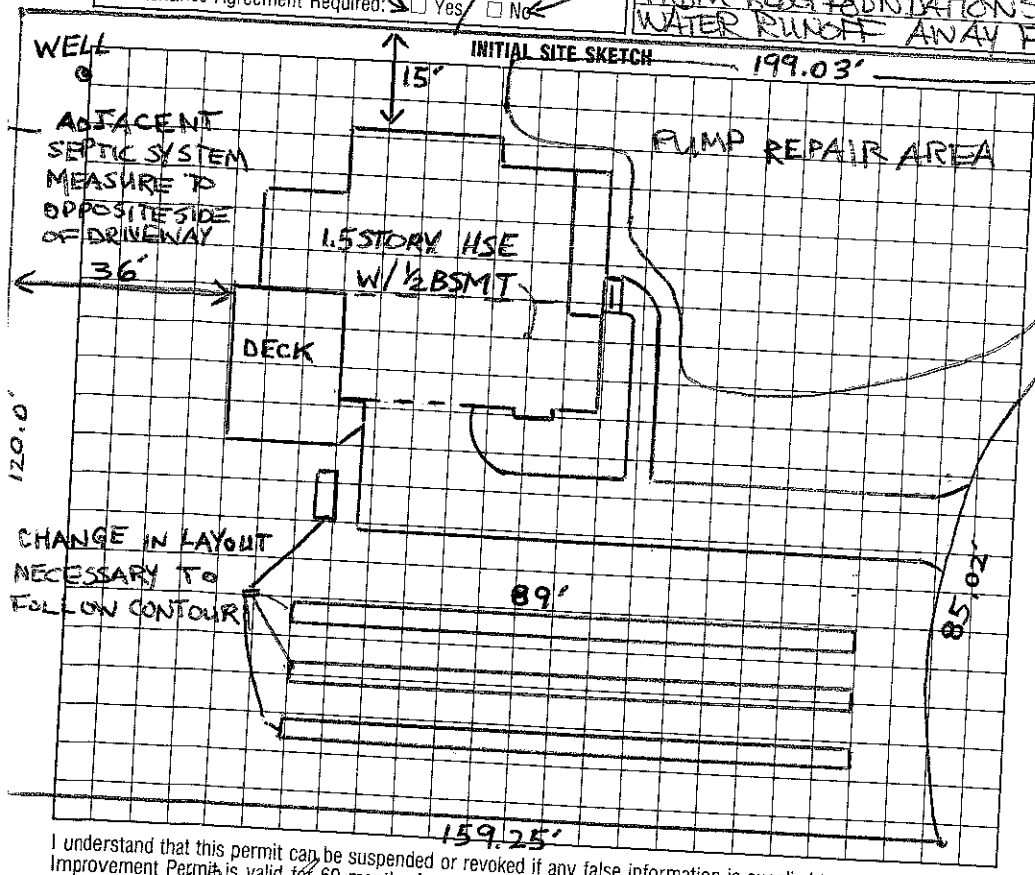

AS BUILT SKETCH 1" = 30'

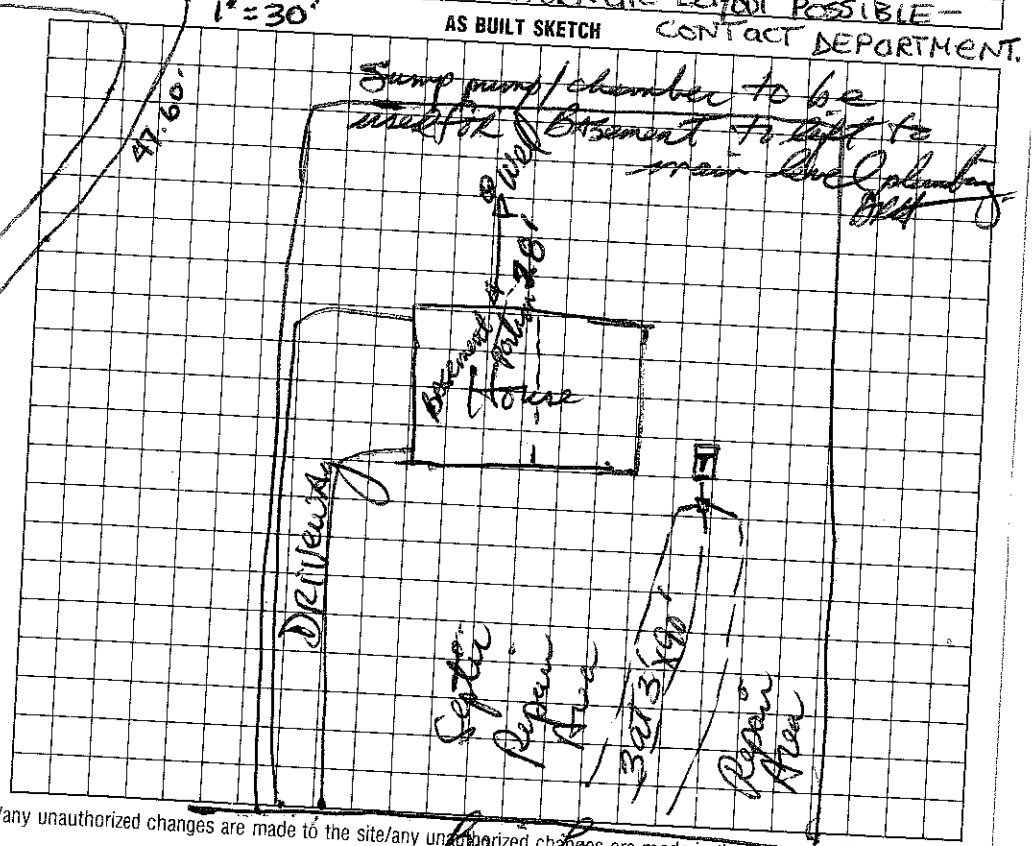

I understand that this permit can be suspended or revoked if any false information is supplied toward securing the permit/any unauthorized changes are made to the site/any unauthorized changes are made in the installation of the system. Improvement Permit is valid for 60 months from date of issuance.

Signed: [signature], Agent

Improvement Permit by: Andrea Lemon date 7-28-93

Existing System Inspection by: date

Installed by: WT Norwood, Bx 99, Waxhaw, NC 28173

Certificate of Completion by: [signature], RS date 10/18/93

Operation Permit by: date

HEALTH DEPT. COPY: WHITE INSPECTION COPY (FINAL): GREEN OWNER COPY (FINAL): YELLOW INSPECTION COPY (INITIAL): PINK OWNER COPY (INITIAL): GOLD