IREDELL COUNTY HEALTH DEPARTMENT

STATESVILLE 704-878-5305 MOORESVILLE 704-664-5281

IMPROVEMENT PERMIT / CERTIFICATE OF COMPLETION / OPERATION PERMIT / EXISTING SYSTEM INSPECTION

11:00

PROPERTY DESCRIPTION NO. 20217 DATE Feb 6, '95 TAX MAP NO. 2A6A3

OWNER OR CONTRACTOR Robert Jacks PHONE: Business BRUH 4645-23-7019 Home Watershed: ☑ Yes ☐ No WS IV

ADDRESS PO Box 5600 - 269 Mooresville

LOCATION 115 S. TR Langtree Rd. TR into Carson's Place on left

SUBDIVISION Carson's Place BLOCK / SECTION LOT 8 LOT AREA ~1.75 Ac SITE CLASS. PS DESIGN FLOW 480 gpd L.T.A.R. 3

Septic Tank: 1000 Gallons; STB Hellinger Date 5-11-95

Pump Tank: Gallons; PT Date

Pump Make: Model Serial No.

Nitrification Field: No Fields 1 Square Feet 1600 Linear Feet 534

No Lines 3+3 Trench Width 36" Max Trench Bottom Depth 36" Gravel Depth 12"

☑ New System ☐ Repair System Type: I, II, III, IV, V, VI

System Description: gravity conventional

Repair System Description: same

Maintenance Agreement Required: ☐ Yes ☑ No

☐ Slab ☑ Crawl Space ☐ Basement w/plumbing ☐ Basement wo/plumbing

☑ House/Mod. Home ☐ Mobile Home ☐ Business ☐ Other


No. Bedrooms 4 No. Bathrooms 3½ No. Employees

Water Supply: ☑ Individual ☐ Community ☐ Public


Comments: Laterals to follow contour

Comments: System installed as shown except 50% reduction due to detached garage built where shown. Repair area appears likely to be infiltration or panel block

INITIAL SITE SKETCH

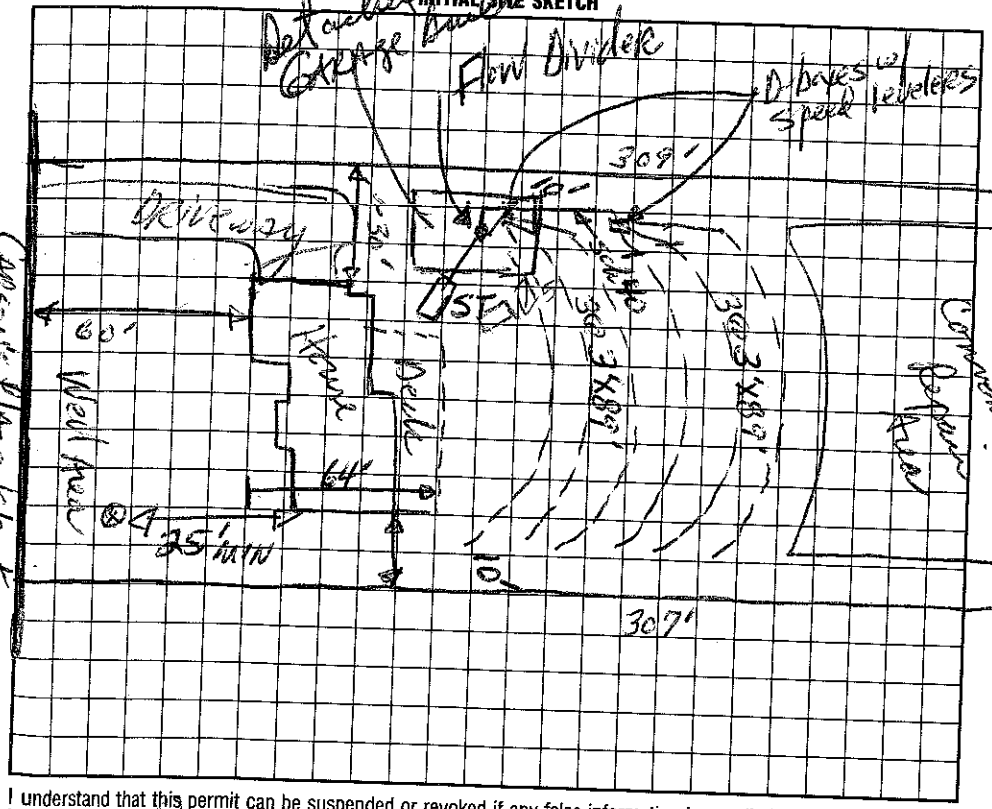

AS BUILT SKETCH

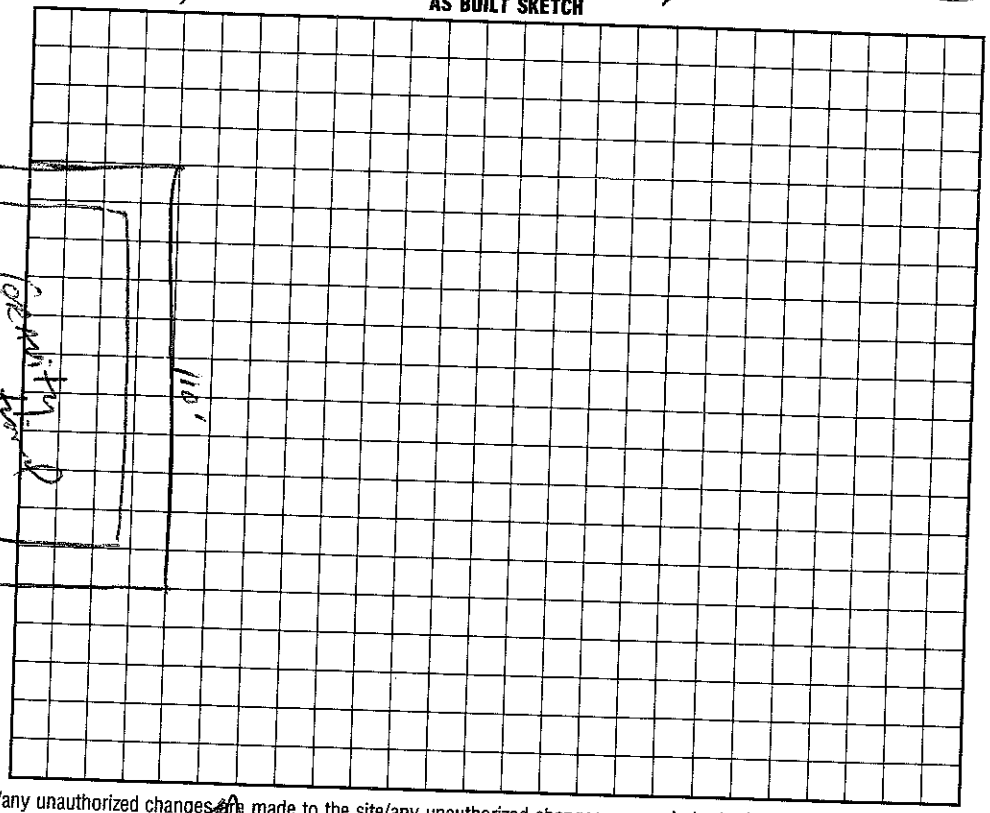

I understand that this permit can be suspended or revoked if any false information is supplied toward securing the permit/any unauthorized changes are made to the site/any unauthorized changes are made in the installation of the system. Improvement Permit is valid for 60 months from date of issuance.

Signed: X Robert Jacks

Improvement Permit by: Harold R. Hutson, RS date 2-6-95

Existing System Inspection by: date

Installed by: A Gibson

Certificate of Completion by: Harold R. Hutson, RS date 7-28-95

Operation Permit by: date

HEALTH DEPT. COPY: WHITE INSPECTION COPY (FINAL): GREEN OWNER COPY (FINAL): YELLOW INSPECTION COPY (INITIAL): PINK OWNER COPY (INITIAL): GOLD