PIN# 4645-23-7300

# IREDELL COUNTY HEALTH DEPARTMENT

STATESVILLE 704-878-5305 MOORESVILLE 704-664-5281

## IMPROVEMENT PERMIT / CERTIFICATE OF COMPLETION / OPERATION PERMIT / EXISTING SYSTEM INSPECTION

PROPERTY DESCRIPTION NO. 16068 DATE APRIL 7, 1993 TAX MAP NO. 2A-6-A-5

OWNER OR CONTRACTOR HAROLD E. ABERNATHY PHONE: Business 704 397 3582 Home 704 537 2818

ADDRESS

LOCATION ON N/S OF LANGTREE ROAD W OF I-77

SUBDIVISION CARSON'S PLACE BLOCK / SECTION LOT 10 LOT AREA .768 SQ FT SITE CLASS. P L.T.A.R. 0.3

Water Supply: ☒ Individual ☐ Community ☐ Public

Septic Tank: ~~1250~~ 1500 Gallons; STB 997 Date 7-7-93

Pump Tank: NA Gallons; PT Date

Nitrification Field: No. Fields 1 Square Feet 1200 Linear Feet 400

No. Lines 5 Trench Width 36" Trench Depth 24" Gravel Depth 12"

☐ New System ☐ Repair System Type: I, II, IV, V, VI

System Description: gravity CONVENTIONAL

Repair System Description: gravity PPBPS

Maintenance Agreement Required: ☐ Yes ☒ No

☒ House/Mod. Home ☐ Mobile Home ☐ Business ☐ Other

No. Bedrooms 3 No. Bathrooms 2 1/2 No. Employees

☐ Slab ☒ Crawl Space ☐ Basement w/plumbing ☐ Basement wo/plumbing

Garbage Disposal: ☒ Yes ☐ No

Auto. Dishwasher: ☒ Yes ☐ No

Auto. Washing Machine: ☒ Yes ☐ No


Other

Comments

### INITIAL SITE SKETCH

ORIGINAL LAYOUT ADJUSTED TO ALLOW FOR SWIMMING POOL BETWEEN HOUSE AND NITRIFICATION FIELD. 15' SET BACK FROM UPPER NIT. LINE TO POOL WALL. DECK/APRON MAY EXTEND TO WITHIN 5' OF NIT. LINE

### AS BUILT SKETCH

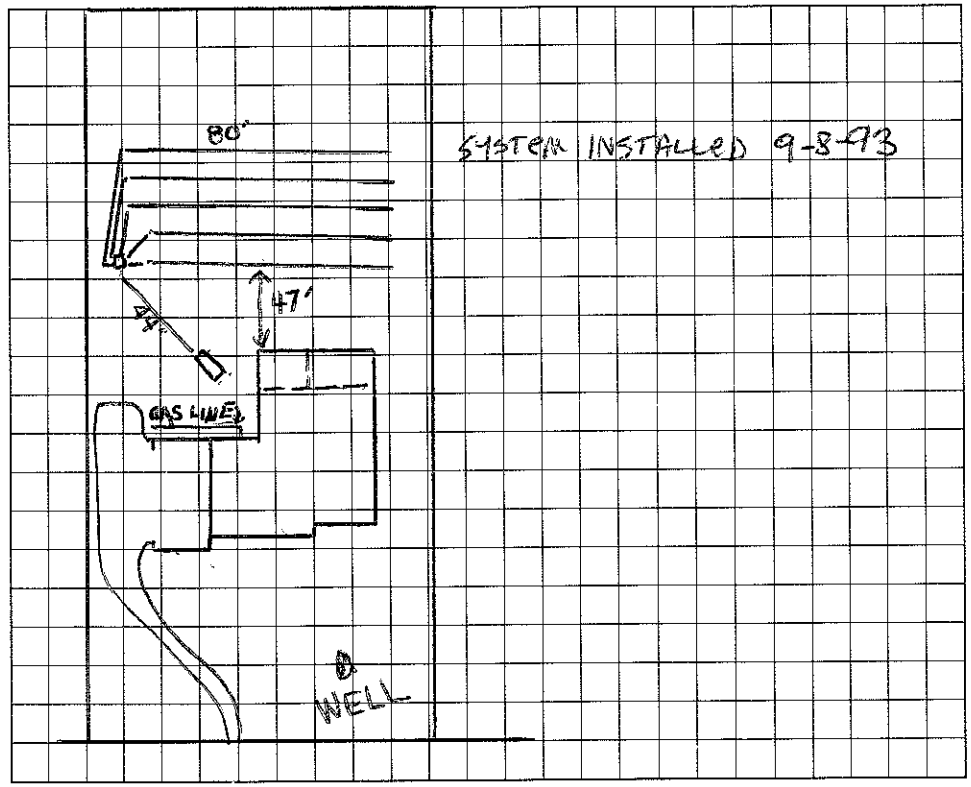


SYSTEM INSTALLED 9-8-93

I understand that this permit can be suspended or revoked if any false information is supplied toward securing the permit/any unauthorized changes are made to the site/any unauthorized changes are made in the installation of the system. Improvement Permit is valid for 60 months from date of issuance.

Signed:

Improvement Permit by: date

Existing System Inspection by: date

Installed by: B.W. Christenbury

Certificate of Completion by: Andrew Comer date 9-8-93

Operation Permit by: date

HEALTH DEPT. COPY: WHITE INSPECTION COPY (FINAL): GREEN OWNER COPY (FINAL): YELLOW INSPECTION COPY (INITIAL): PINK OWNER COPY (INITIAL): GOLD