IREDELL COUNTY HEALTH DEPARTMENT

STATESVILLE 704-878-5305 MOORESVILLE 704-664-5281

IMPROVEMENT PERMIT / AUTHORIZATION TO CONSTRUCT / OPERATION PERMIT / EXISTING SYSTEM INSPECTION

PERMIT# 088025 PIN# 8645 25 6492

OWNER OR CONTRACTOR Paul Henderson DATE 3/17/00

ADDRESS 215 Queens Cove Rd. Mocksville PHONE: Business Home 663-2470

LOCATION Harwell Dr. TR to # 215 on (R)

SUBDIVISION Queens Cove BLOCK / SECTION 2 LOT 27 LOT AREA SITE CLASS. DESIGN FLOW 480 L.T.A.R.

Septic Tank: Gallons; STR Date

Pump Tank: Gallons; PT Existing System Date

Pump Make: Model Serial No.

Nitrification Field: No Fields Square Feet Linear Feet

No Lines Trench Width Max Trench Bottom Depth Gravel Depth

☐ New System ☐ Repair System Type: I (II) III. IV. V. VI

System Description: Drw-Conv.-Existing

Repair System Description:

Maintenance Agreement Required: ☐ Yes ☒ No

☒ House/Mod. Home No. Bedrooms 4

☐ Mobile Home No. Bathrooms 4.5

☐ Business No. Employees

☐ Other

☐ Slab ☐ Crawl Space ☒ Basement w/plumbing ☐ Basement wo/plumbing

Water Supply: ☒ Individual ☐ Public ☐ Community


Comments:/Conditions:

Comments:/Conditions:

MARSHALL HENDERSON - 1990

INITIAL SITE SKETCH

AS BUILT SKETCH

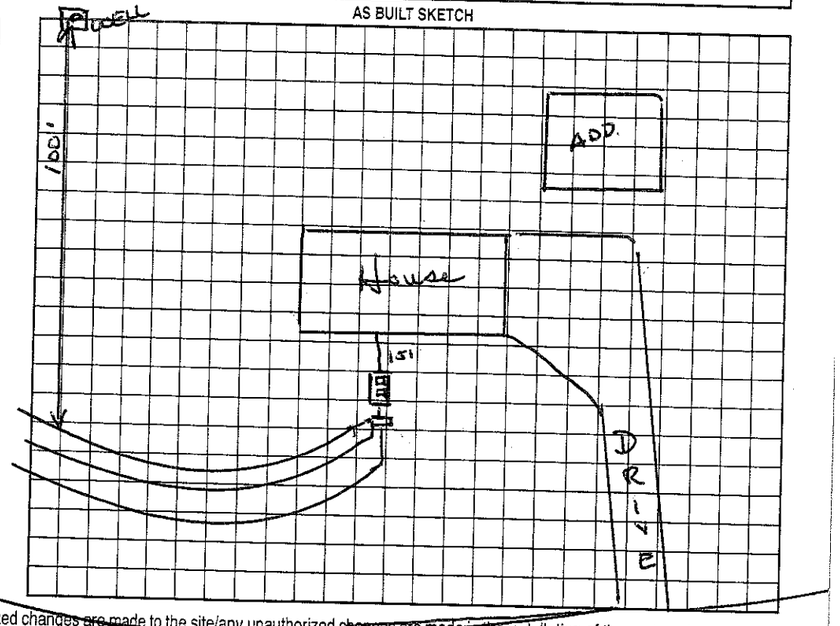

Permit can be suspended or revoked if any false information is supplied toward securing the permit/any unauthorized changes are made to the site/any unauthorized changes are made in the installation of the system. Improvement Permit with plat valid without expiration. Improvement Permit with site plan valid for sixty months. Authorization to Construct is valid for a period equal to that of Improvement Permit – not to exceed sixty months.

Signed: date

Improvement Permit by: date

Authorization to Construct by: date

Installed by: Yountz Queenscove Rd.

Operation Permit by: date

Existing System Inspection by: Wesley Sparks RS date 3/17/00

HEALTH DEPT. COPY: WHITE OWNER COPY (FINAL): YELLOW OWNER COPY (INITIAL): PINK