IREDELL COUNTY HEALTH DEPARTMENT

STATESVILLE 704-878-5305 MOORESVILLE 704-664-5281

IMPROVEMENT PERMIT / AUTHORIZATION TO CONSTRUCT / OPERATION PERMIT / EXISTING SYSTEM INSPECTION

PERMIT# 092128 PIN# 4645 26 2405

OWNER OR CONTRACTOR Tom Perreault DATE 10/26/00

ADDRESS [redacted] 330 Queens Cove Mooresville, NC 28117 PHONE: Business 664-2191 Home

LOCATION Williamson Rd S TR Alcove TR Templeton TL Queens Cove Rd, TR Forum Dr., on (L) just past Access Road.

SUBDIVISION Queens Cove BLOCK / SECTION 3 LOT 171 LOT AREA ~.82AC SITE CLASS. PS DESIGN FLOW 480 L.T.A.R. .3

Septic Tank: 1000 Gallons; STB 794 Date 4/28/01

Pump Tank: 1000 Gallons; PT 29 Date 8/24/01

Pump Make: GOULDS Model WED-511H Serial No. 8/6/01

Nitrification Field: No Fields 1 Square Feet 1200* Linear Feet 400*

No Lines 5@80' Trench Width 3' Max Trench Bottom Depth 3' Gravel Depth STNA.

☒ New System ☐ Repair System Type: I, II, (III), IV, V

System Description: EZ Flow - CH. PLASTIC Pump

Repair System Description: New

Maintenance Agreement Required: ☐ Yes ☒ No

☒ House/Mod. Home ☐ Mobile Home ☐ Business ☐ Other

No. Bedrooms 4 No. Bathrooms 4 No. Employees


☐ Slab ☐ Crawl Space ☒ Basement w/plumbing ☐ Basement wo/plumbing

Water Supply: ☒ Individual ☐ Public ☐ Community


Comments:/Conditions: * This is a 25% reduced system.

Comments:/Conditions:

INITIAL SITE SKETCH (1" = 50')

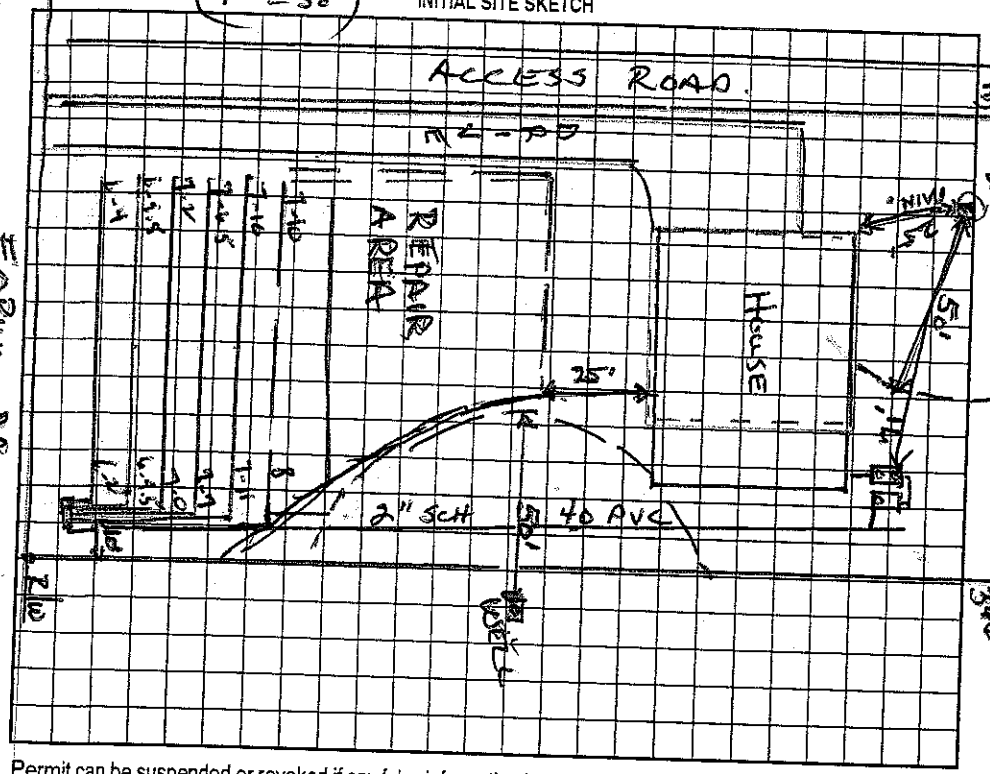

AS BUILT SKETCH

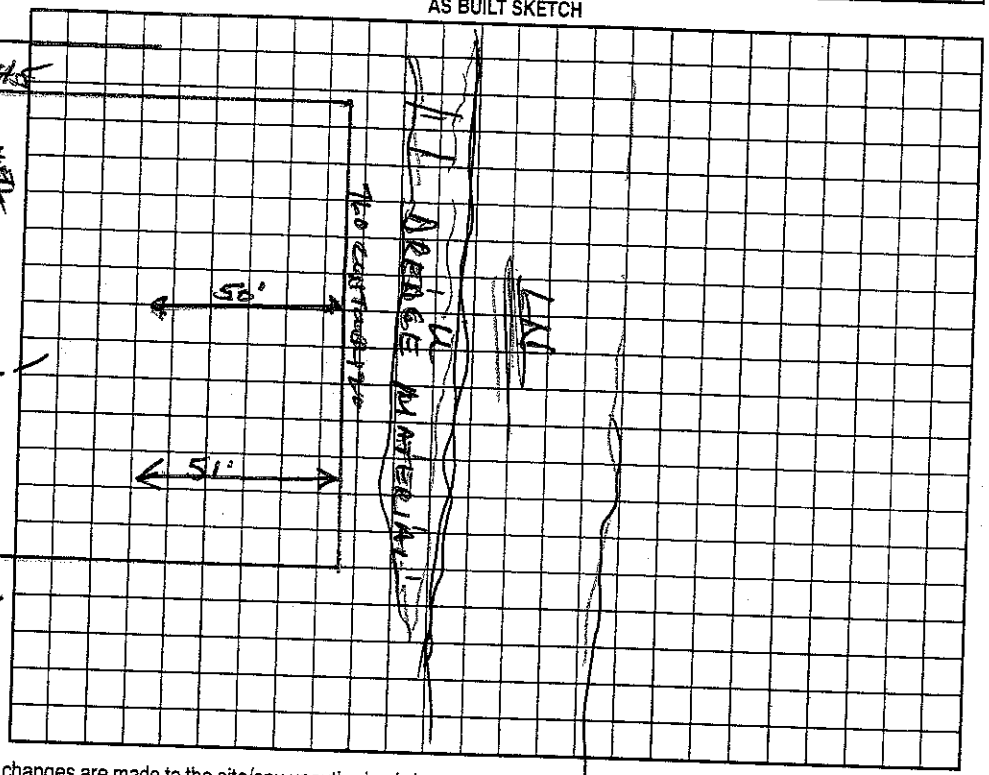

FORUM DR.

Permit can be suspended or revoked if any false information is supplied toward securing the permit/any unauthorized changes are made to the site/any unauthorized changes are made in the installation of the system. Improvement Permit with plat valid without expiration. Improvement Permit with site plan valid for sixty months. Authorization to Construct is valid for a period equal to that of Improvement Permit – not to exceed sixty months.

Signed: Karen V. Perreault date 10/24/00 Installed by: Wayne Dobson

Improvement Permit by: Wesley Sparks R.S. date 10/20/00 Operation Permit by: Wesley Sparks R.S. date 11/5/01

Authorization to Construct by: Wesley Sparks R.S. date 10/26/00 Existing System Inspection by: date

HEALTH DEPT. COPY: WHITE OWNER COPY (FINAL): YELLOW OWNER COPY (INITIAL): PINK