IREDELL COUNTY HEALTH DEPARTMENT

STA[illegible] 704-878-5305 130.00 Paid MOORESVILLE 704-664-5281 11:30

IMPROVEMENT PERMIT / AUTHORIZATION TO CONSTRUCT / OPERATION PERMIT / EXISTING SYSTEM INSPECTION

PERMIT# 127760 PIN# 4645 24 3527.000 DATE 5/5/05

OWNER OR CONTRACTOR Preston + Martha Cornelius / GP Con PHONE: Business 704-662-9705 Home

ADDRESS 2027 Charlotte Hwy Mooresville, NC 28117

LOCATION Forum Dr. & Alcove Rd TR Templeton L first TL Queens Cove TR Forum, on (L) By Access lot.

SUBDIVISION Queen Cove BLOCK / SECTION 53 LOT 120 LOT AREA .95AC SITE CLASS. PS DESIGN FLOW 480 L.T.A.R. .3

Septic Tank: 1000 Gallons; STB 194 Date 1-27-07
Pump Tank: 1000 Gallons; PT 27 Date 12-23-06
Pump Make: Myers Model ME50 Serial No.
Nitrification Field: No. Fields 1 Square Feet 1200± Linear Feet 400±
No. Lines 4@ 100' Trench Width 3' Max Trench Bottom Depth 3' Gravel Depth NA

☒ New System ☐ Repair System Type: I, II, III, IV, V, VI
System Description: ~~PM~~ → 25% Reduced
Repair System Description: Pressure 16" PPBAS
Maintenance Agreement Required: ☐ Yes ☒ No

☒ House/Mod. Home ☐ Mobile Home ☐ Business ☐ Other
No. Bedrooms 4 No. Bathrooms 4 No. Employees
☐ Slab ☐ Crawl Space ☒ Basement w/plumbing ☐ Basement wo/plumbing

Water Supply: ☒ Individual ☐ Public ☐ Community

Comments/Conditions: Note: FAST TRACK SEE ATTACHED PLAN BY ROLLINS SOIL + ENVIR. SVCS. LINES 3, 4, 5, + 6 ARE TO BE INSTALLED IN MANNER SHOWN ON SITE PLAN


Comments/Conditions: > 50ft From tanks to well
3/8/07 Checked tanks
3/29/07 Checked E/Flow Drain lines
3/29/07 Checked pres. Elect & alarm.

INITIAL SITE SKETCH

3/29/07 Appears DrainField has had a lot of traffic over it, somewhat Compacted.

SEE ATTACHED FAST TRACK SITE PLAN

AS BUILT SKETCH

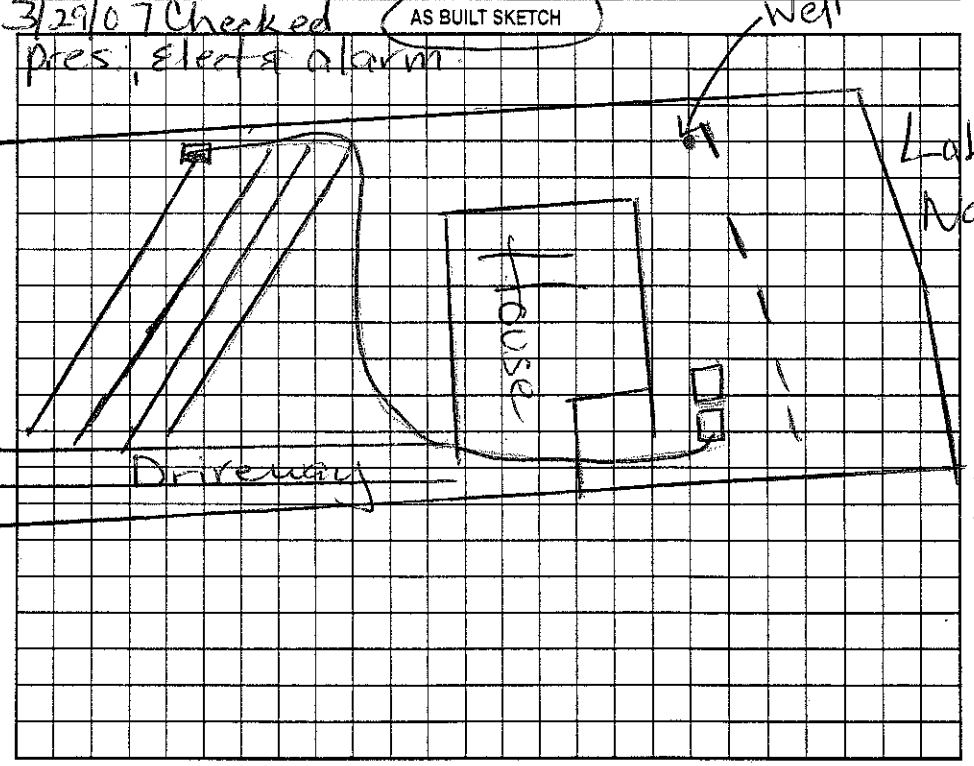

Permit can be suspended or revoked if any false information is supplied toward securing the permit/any unauthorized changes are made to the site/any unauthorized changes are made in the installation of the system. Improvement Permit with plat valid without expiration. Improvement Permit with site plan valid for sixty months. Authorization to Construct is valid for a period equal to that of Improvement Permit – not to exceed sixty months.

Signed: [signature] date

Improvement Permit by: Wesley Sparks date 5/5/05

Authorization to Construct by: [signature] Wesley Sparks date 4-6-06

Installed by: K a T RS

Operation Permit by: Marvin Dotson date 3/29/07

Existing System Inspection by: date

HEALTH DEPT COPY: WHITE 4/6/06 OWNER COPY (FINAL): YELLOW OWNER COPY (INITIAL): PINK