IREDELL COUNTY HEALTH DEPARTMENT

STATESVILLE 704-878-5305 50.00 Paid MOORESVILLE 704-664-5281

IMPROVEMENT PERMIT / AUTHORIZATION TO CONSTRUCT / OPERATION PERMIT / EXISTING SYSTEM INSPECTION

PERMIT# 090941 PIN# 4645 265 921 DATE 2/18/02

OWNER OR CONTRACTOR Keith Daniel Goss PHONE: Business _____ Home 704-664-1978

ADDRESS 136 Emerald Ln Mooresville NC 28117

LOCATION Williamson to Alcove, TR Templeton, TL Queens Cove on Corner of Forum

SUBDIVISION Queens Cove BLOCK / SECTION 3 LOT 117 LOT AREA 1.5AC SITE CLASS. PS DESIGN FLOW 450 L.T.A.R. 0.3

Septic Tank: 1000 Gallons; STB 825 Date 10/3/03

Pump Tank: 1000 Gallons; PT 302 Date 9/8/03

Pump Make: ZOELLER Model N-93B Serial No. 10/25/03

Nitrification Field: No Fields 1 Square Feet 1200 Linear Feet 400

No Lines 3@133' Trench Width 36" Max Trench Bottom Depth 24"

☒ New System ☐ Repair System Type: I, II, III, IV, V, VI

System Description: Pump 25% Reduction

Repair System Description: ~~5000~~ LP 25% Red

Maintenance Agreement Required: ☐ Yes ☒ No

Gravel Depth —

☒ House/Mod. Home ☐ Mobile Home ☐ Business ☐ Other

No. Bedrooms 4 No. Bathrooms 3½ No. Employees ____

☐ Slab ☐ Crawl Space ☒ Basement w/plumbing ☐ Basement wo/plumbing

Water Supply: ☒ Individual ☐ Public ☐ Community


Comments:/Conditions:

Keep Well 100' from Septic System

Comments:/Conditions:

May use 4@100' - 1/6/03 400' of shallow trench installed

INITIAL SITE SKETCH

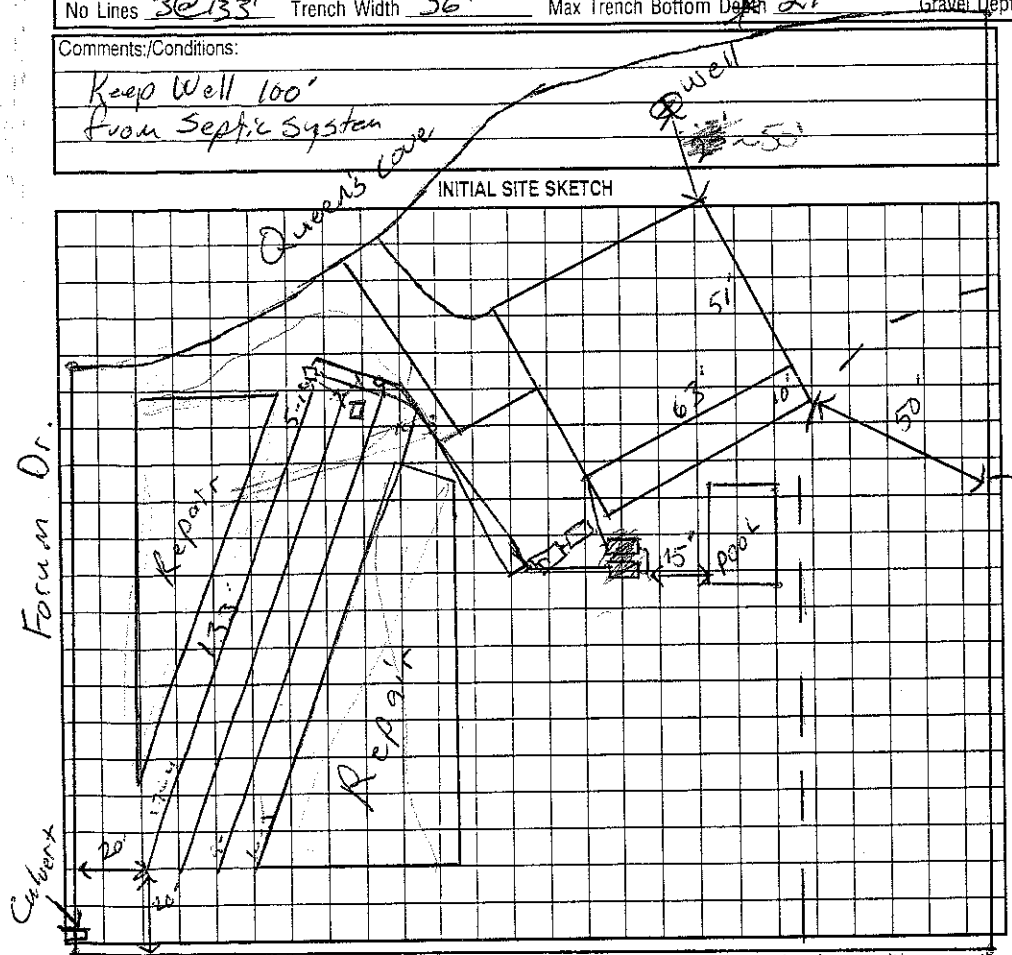

AS BUILT SKETCH

CHECKED ELEC. & ALARM

Permit can be suspended or revoked if any false information is supplied toward securing the permit/any unauthorized changes are made to the site/any unauthorized changes are made in the installation of the system. Improvement Permit with plat valid without expiration. Improvement Permit with site plan valid for sixty months. Authorization to Construct is valid for a period equal to that of Improvement Permit – not to exceed sixty months.

Signed: Keith Daniel Goss date 2/19/02 Installed by: Rowan Septic Tank

Improvement Permit by: RS date 2/18/02 Operation Permit by: BAC date 2-1-13

RS date 2/18/02 Existing System Inspection by: _____ date _____

(FINAL): YELLOW OWNER COPY (INITIAL): PINK