IREDELL COUNTY HEALTH DEPARTMENT

IMPROVEMENT PERMIT / AUTHORIZATION TO CONSTRUCT / OPERATION PERMIT / EXISTING SYSTEM INSPECTION

STATESVILLE 704-878-5305 (O) MOORESVILLE 704-664-5281

PERMIT# 107915 PIN# 4645 26 6330

OWNER OR CONTRACTOR Mark Goodman PHONE: Business _____ Home 704-799-6696

ADDRESS 170 Queens Cove Rd. Mooresville, NC. 28117 DATE 8/2/02

LOCATION Williamson Rd STR Dexter TR Templeton Rd. (L) at Oak Tree TL Queens Cove Rd to #170 on (R)

SUBDIVISION Queens Cove BLOCK / SECTION 3 LOT 113 LOT AREA _____ SITE CLASS. _____ DESIGN FLOW 480 L.T.A.R. _____

Septic Tank: EXISTING Gallons: STB _____ Date _____

Pump Tank: _____ Gallons: PT _____ Date _____

Pump Make: _____ Model _____ Serial No. _____

Nitrification Field: No Fields _____ Square Feet _____ Linear Feet _____

No Lines _____ Trench Width _____ Max Trench Bottom Depth _____ Gravel Depth _____

☐ New System ☐ Repair System Type: I. (II) III. IV. V. VI

System Description: EXISTING SYSTEM

Repair System Description: _____

Maintenance Agreement Required: ☐ Yes ☒ No

☐ Slab ☐ Crawl Space ☒ Basement w/plumbing ☐ Basement wo/plumbing

☒ House/Mod. Home No. Bedrooms 4

☐ Mobile Home No. Bathrooms ___

☐ Business No. Employees ___

☒ Other Rec Room in Bsmt.

Water Supply: ☒ Individual ☐ Public ☐ Community

Comments:/Conditions:


EXISTING SYSTEM

INITIAL SITE SKETCH

Comments:/Conditions:

LN

AS BUILT SKETCH

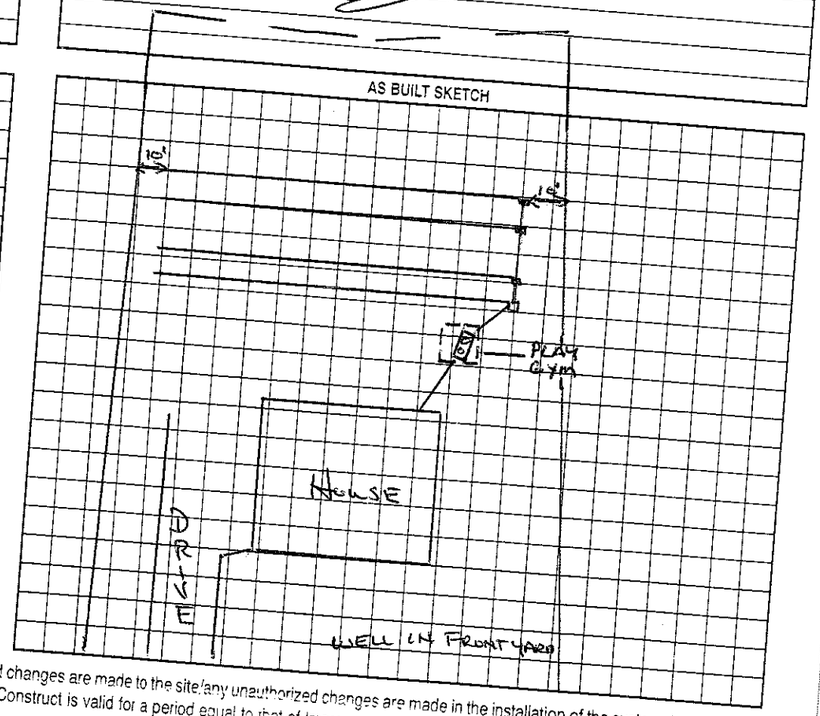

Permit can be suspended or revoked if any false information is supplied toward securing the permit/any unauthorized changes are made to the site/any unauthorized changes are made in the installation of the system. Improvement Permit with plat valid without expiration. Improvement Permit with site plan valid for sixty months. Authorization to Construct is valid for a period equal to that of Improvement Permit – not to exceed sixty months.

Signed: Mark Goodman

Improvement Permit by: _____ date 8/2/02

Authorization to Construct by: _____ date _____

Installed by: _____

Operation Permit by: _____ date _____

Existing System Inspection by: Wesley Sparks RS date 8/2/02

HEALTH DEPT. COPY: WHITE OWNER COPY (FINAL): YELLOW OWNER COPY (INITIAL): PINK