IREDELL COUNTY HEALTH DEPARTMENT

STATESVILLE 704-878-5305 MOORESVILLE 704-664-5281

IMPROVEMENT PERMIT / CERTIFICATE OF COMPLETION / OPERATION PERMIT / EXISTING SYSTEM INSPECTI

PROPERTY DESCRIPTION NO. 17892 DATE Sept 22, '94 TAX MAP NO. 2H 11 C 113 Watershed: ☑ Yes ☐ No

OWNER OR CONTRACTOR Lea Chris Couch PHONE: Business _____ Home _____

ADDRESS _____ EN 4645-26-6330

LOCATION 1206 (Alcove) TR Templeton TR Camino Real TR Queens Circle ± .2 mile on Right

SUBDIVISION Queens Cove BLOCK / SECTION 3 LOT 113 LOT AREA ~38,000ft² SITE CLASS. PS DESIGN FLOW 480 gpd L.T.A.R. 0.3

Septic Tank: 1000 Gallons; STB Bill Hellinger Date 2-28-95

Pump Tank: _____ Gallons; PT _____ Date _____

Pump Make: _____ Model _____ Serial No. _____

Nitrification Field: No Fields 2 Square Feet 1620 Linear Feet 540

No Lines 3+3 Trench Width 36" Max Trench Bottom Depth 30" Gravel Depth 12"

☑ New System ☐ Repair System Type: I, II, III, IV, V, VI

System Description: gravity conventional

Repair System Description: Bruce PBTS

Maintenance Agreement Required: ☐ Yes ☑ No

☑ House/Mod. Home No. Bedrooms 4

☐ Mobile Home No. Bathrooms 2½

☐ Business No. Employees ____

☐ Other _____


☐ Slab ☐ Crawl Space ☑ Basement w/plumbing ☐ Basement wo/plumbing

Water Supply: ☑ Individual ☐ Community ☐ Public


Comments: Install 270' for each subfield. Follow contour w/ laterals.

Comments: Upper field in 4 laterals also.

INITIAL SITE SKETCH

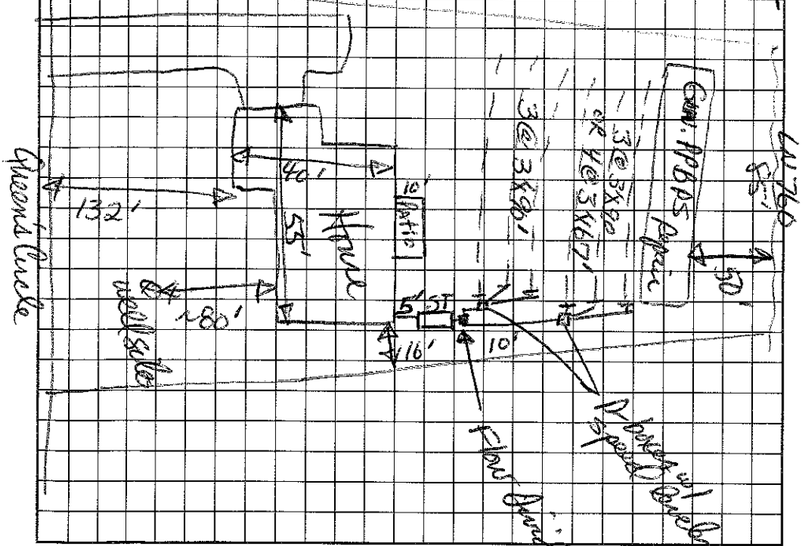

AS BUILT SKETCH

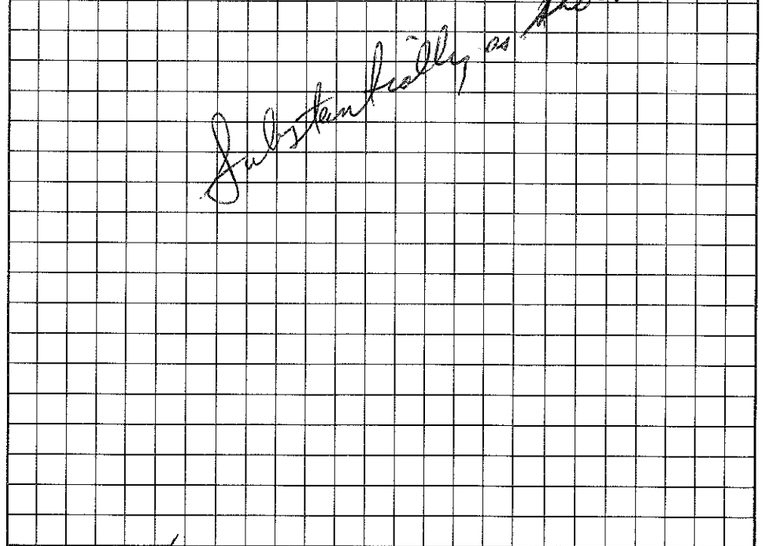

I understand that this permit can be suspended or revoked if any false information is supplied toward securing the permit/any unauthorized changes are made to the site/any unauthorized changes are made in the installation of the system. Improvement Permit is valid for 60 months from date of issuance.

Signed: _____

Improvement Permit by: Jack K Hinson, RS date 9-22-94

Existing System Inspection by: _____ date _____

Installed by: Kenny Bellinger

Certificate of Completion by: DK Hinson, RS date 5/16/95

Operation Permit by: _____ date _____

HEALTH DEPT. COPY: WHITE INSPECTION COPY (FINAL): GREEN OWNER COPY (FINAL): YELLOW INSPECTION COPY (INITIAL): PINK OWNER COPY (INITIAL): GOLD