IREDELL COUNTY HEALTH DEPARTMENT

Statesville Office (704) 878-5305 Mooresville Office (704) 660-3625 PERMIT # 2130 202676

IMPROVEMENT PERMIT / AUTHORIZATION TO CONSTRUCT / OPERATION PERMIT / EXISTING SYSTEM

PIN # 4645266596

APPLICANT: Leonard Prowler APPLICANT ADDRESS: 154 Queens Cove Rd Mooresville, NC

SITE ADDRESS: 154 Queens Cove Rd Mooresville, NC PHONE: 7046600874 ALT. PHONE: 7046049-6188

SITE DIRECTIONS: Alcove Rd TR Templeton Rd TL Camino Real Rd TL Queen's Cove Rd past Forum on Rt

SUBDIVISION: Queens Cove SECTION: III LOT # 115 LOT AREA: 1.52 Ac DESIGN FLOW: 480gpd L.T.A.R.: .275


EXIST / ADDITION

Septic Tank	1000 (gal)	STB	Date	☐ New System ☐ Repair ☒ Expansion	System Type: I II III (IV) V VI	☒ Residence	No. Bedrooms	4	Water Supply
Pump Tank	1000 (gal)	PT	Date	System Description:	LP-Panel Block	☐ Business	No. Persons		☒ Private
Pump Make		Model	Serial #	Repair System Description:	Same	☐ Other	No. Employees		☐ Public
# Nitrification Fields	1	# Lines	2	Linear Ft: 72 - 74	Maintenance Agreement Required: ☒ YES ☐ NO	☐ Slab	☐ Crawl Space		☐ Community
Trench Width	24"	Max. Trench Bottom Depth	36"	Gravel Depth	N/A ☐ GRAVITY ☒ PRESSURE	☒ Basement w/plumbing		☐ Basement w/o plumbing	

Comments / Conditions: *Add 2 lines (1-30 & 1-44ft) to Existing Septic System to upgrade to 4Bedroom Drill 3/16" hole in panels.

*OK to Valve New lines or Set Central Gate Valve box and Connect all lines to it. Must have Current Maint. Agreement prior to Operation Permit being issued. 6/10/14 Checked new drainlines

INITIAL SITE SKETCH

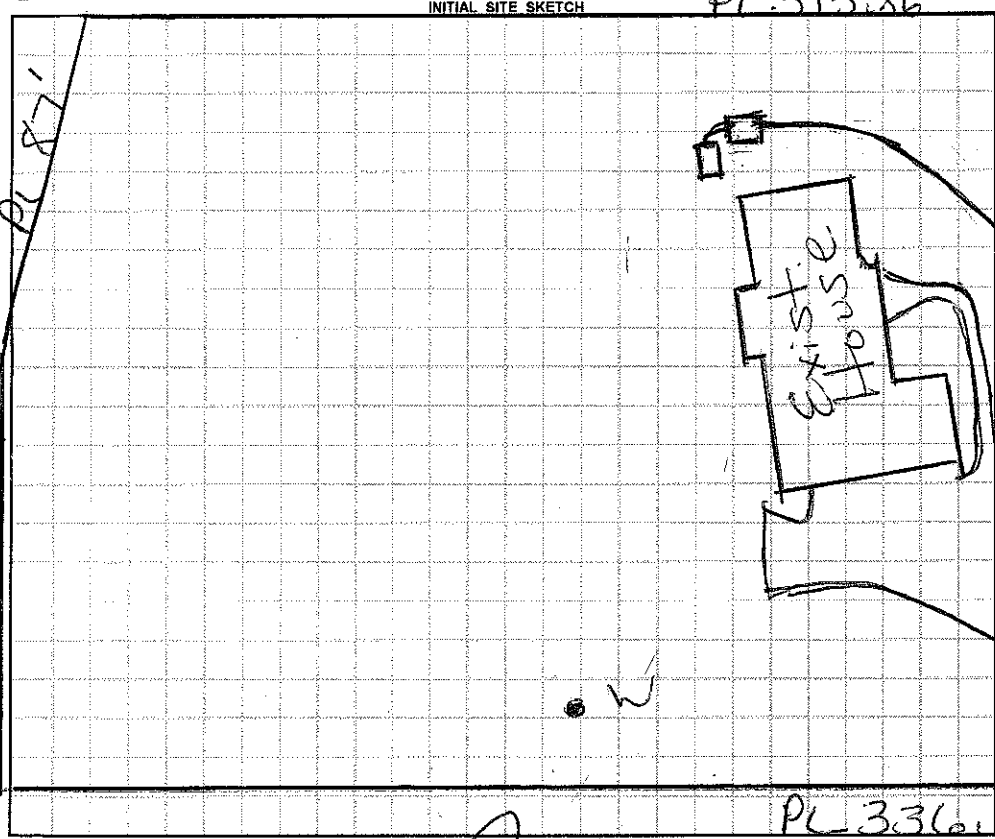

AS BUILT SKETCH

Permit can be suspended or revoked if any false information is supplied toward securing the permit / any unauthorized changes are made to the site / any unauthorized changes are made in the installation of the system. **CONTACT A LOCATOR SERVICE PRIOR TO ANY EXCAVATION**

☐ **IMPROVEMENT PERMIT** *with plat valid without expiration.* ☐ **IMPROVEMENT PERMIT** *with site plan valid for 60 mos.* ☐ **AUTHORIZATION TO CONSTRUCT** *valid for period equal to IMPROVEMENT PERMIT--not to exceed 60 mo.*

Owner / Applicant Signature: Leonard Prowler RS Date: 6/6/14 Installed by: E.J Ervin RS

IMPROVEMENT PERMIT by: [signature] Date: 6/6/14 OPERATION PERMIT by: [signature] Date: 6/17/14

AUTHORIZATION TO CONSTRUCT by: [signature] Date: 6/6/14 Existing System Inspected by: Date:

Health Dept. Copy - WHITE Applicant (Final Approval) - YELLOW Applicant (Conditional Approval) - PINK