IMPROVEMENT PERMIT / AUTHORIZATION TO CONSTRUCT / OPERATION PERMIT / EXISTING SYSTEM INSPECTION

PERMIT # 173883 PIN # 4645271153 DATE 8-14-2012

OWNER or APPLICANT DG Custom Homes / Justin Mount PHONE: Business 704 400-2307 Home: 704 604-1250

OWNER or APPLICANT ADDRESS 631-407 Brawley School Rd Mooresville NC 28117

LOCATION / DIRECTIONS Alcove Rd TR Templeton TL Camino Real (at fork) lot on left at Queens Cove Rd

SUBDIVISION Queens Cove BLOCK / SECTION LOT # 131 LOT AREA 1.52Ac DESIGN FLOW L.T.A.R. .3

Septic Tank 1000 Gallons: STB 1012 Date 11-15-11

Pump Tank 1000 Gallons: PT 17 Date 9-17-10

Pump Make Goulds Model WFE0312M Serial #

Nitrification Field No Fields 1 No Lines 4 Linear Feet 400

Trench Width 36" Max. Trench Bottom Depth 24-36 Gravel Depth N/A

☒ New System ☐ Repair ☐ Expansion System Type I II III IV V VI

System Description: Pump-Pm - 25% Reduction

Repair System Description: Same

Maintenance Agreement Required ☐ YES ☒ NO

☐ GRAVITY ☒ PRESSURE

☒ Residence No. Bedrooms 4

☐ Business No. Persons

☐ Other No. Employees

☐ Slab ☒ Crawl Space

☐ Basement w/plumbing ☐ Basement w/o plumbing


Water Supply: ☒ Private ☐ Public ☐ Community

Comments / Conditions ☆ Prefer to install trenches @ 24"


Comments / Conditions 5/30/13 Installed Quick 4 essentially as Drawn Checked tanks & lines 5/30/13 Set 2 Pt pressure Checked Elect & Alarm

Scale 1:50

INITIAL SITE SKETCH

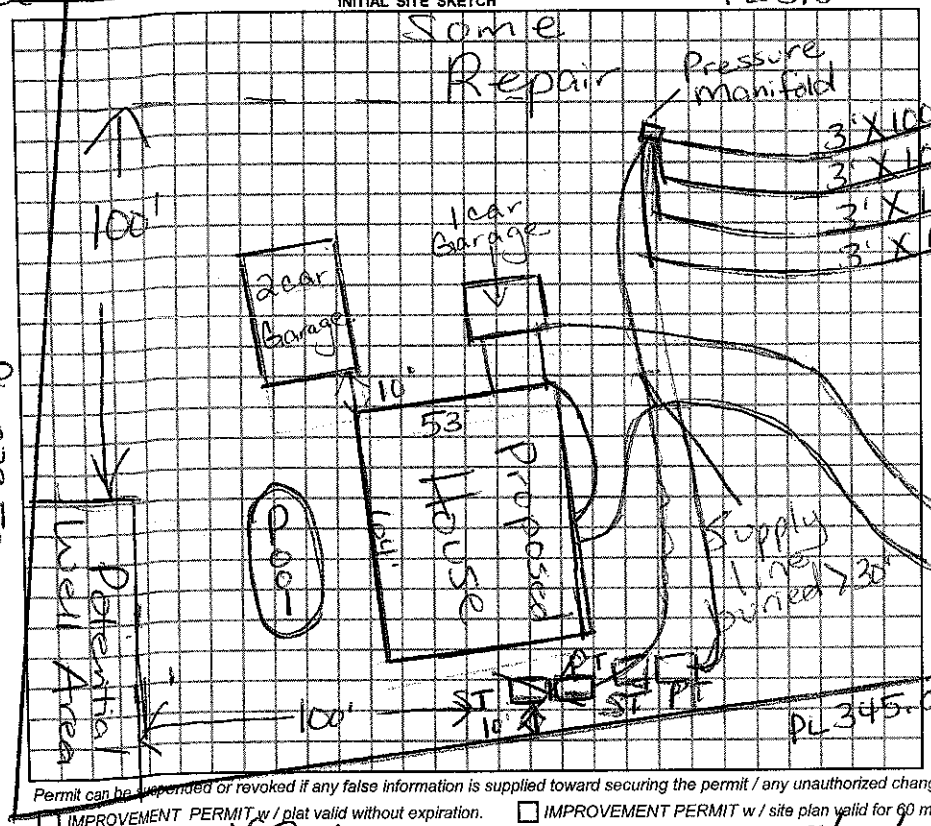

AS BUILT SKETCH

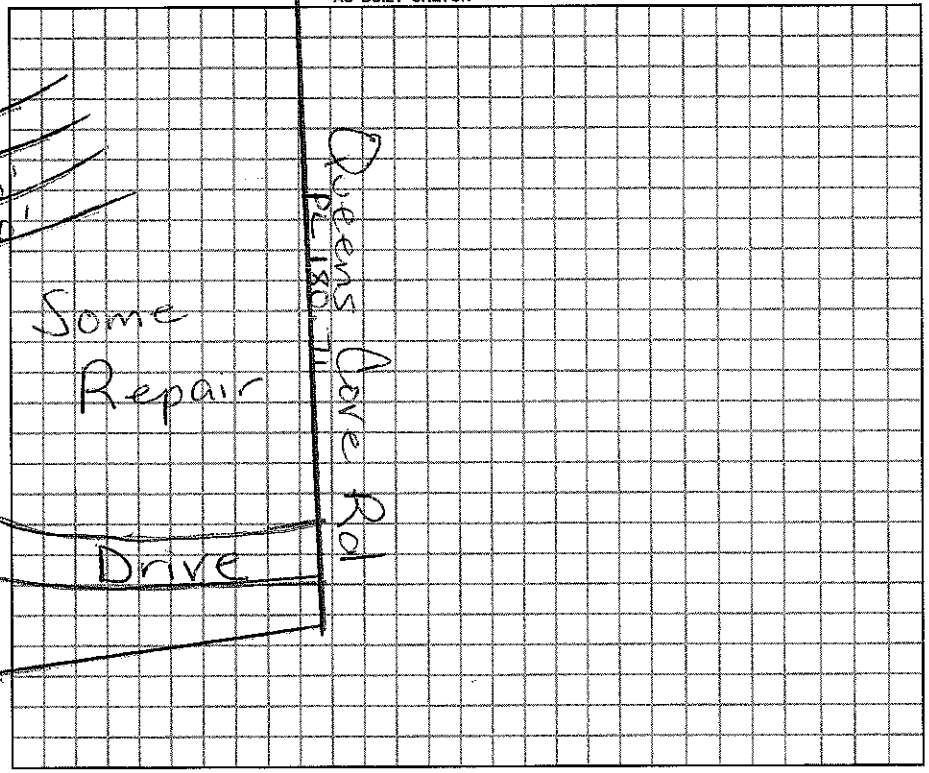

Permit can be suspended or revoked if any false information is supplied toward securing the permit / any unauthorized changes are made to the site / any unauthorized changes are made in the installation of the system.

☐ IMPROVEMENT PERMIT w / plat valid without expiration. ☐ IMPROVEMENT PERMIT w / site plan valid for 60 mos. ☐ AUTHORIZATION TO CONSTRUCT valid for period equal to IMPROVEMENT PERMIT-not to exceed 60 mo.

Owner / Applicant Signature: DG Custom Homes RS Date 8/15/12

Improvement Permit by: Mark Thompson RS Date 8/14/12

Authorization to Construct by: Mark Thompson RS Date 8/15/12

Installed by: Steve Jordan RS

Operation Permit by: Mark Thompson Date: 5/30/13

Existing System Inspected by: Date:

I SHOULD CONTACT A LOCATOR SERVICE PRIOR TO ANY EXCAVATION.

WHITE COPY Environmental Health YELLOW COPY (Final) Owner / Applicant PINK COPY (Initial) Owner / Applicant