IREDELL COUNTY HEALTH DEPARTMENT

STATESVILLE 704-878-5305 MOORESVILLE 704-664-5281

IMPROVEMENT PERMIT / AUTHORIZATION TO CONSTRUCT / OPERATION PERMIT / EXISTING SYSTEM INSPECTION

PERMIT# 141781 PIN# 9645 28 1746 DATE 6-25-07

OWNER OR APPLICANT Dave White PHONE: Business 309-4301 Home

ADDRESS 131 Lynn Cove Ln Mooresville, NC 28117

LOCATION Templeton Rd TR Lynn Cove Rd to 6th lot on left # 131 Lyngcove

SUBDIVISION Morgan Landing BLOCK / SECTION J LOT 6 LOT AREA SITE CLASS. PS DESIGN FLOW 360 gpd L.T.A.R. 3

Existing

Septic Tank: 1000 Gallons; STB Date

Pump Tank: Gallons; PT Date

Pump Make: Model Serial No.

Nitrification Field: No Fields 1 Square Feet 900 Linear Feet 300

No Lines 4@75' Trench Width 36" EMax Trench Bottom Depth Gravel Depth N/A

☐ New System ☐ Repair ☐ Expansion System Type: I II III IV V VI

System Description: Existing Gravity - 25% Reduction

Repair System Description: LPP Panel Block

Maintenance Agreement Required: ☐ Yes ☒ No

☒ House/Mod. Home ☐ Mobile Home ☐ Business ☐ Other

No. Bedrooms 3 No. Persons No. Employees


Water Supply: ☒ Individual ☐ Public ☐ Community

☐ Gravity ☑ Pressure ☐ Slab ☒ Crawl Space ☐ Basement w/plumbing ☐ Basement wo/plumbing

Comments/Conditions: Existing Septic System appears to be functioning Okay at time of inspection. No problems Noticed

Comments/Conditions: Okay to expand Porch/Deck however Number of Bedrooms must stay at 3 Bedrooms. Any pool cut must be 15ft from Septic System (including Repair)

Scale ~ 1:40 INITIAL SITE SKETCH

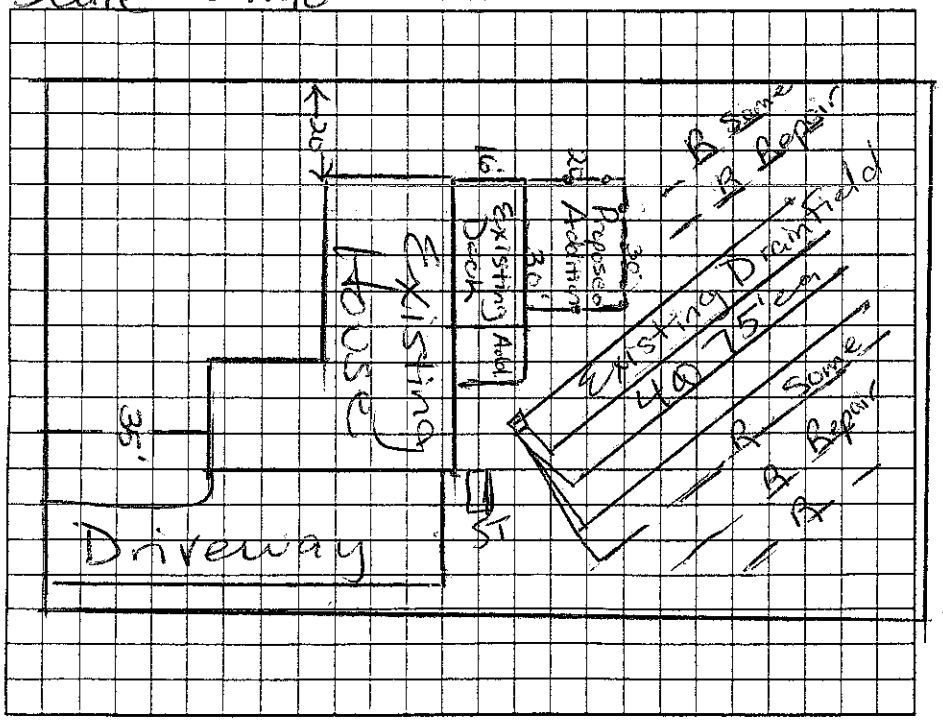

AS BUILT SKETCH

Permit can be suspended or revoked if any false information is supplied toward securing the permit/any unauthorized changes are made to the site/any unauthorized changes are made in the installation of the system. Improvement Permit with plat valid without expiration ☐ Improvement Permit with site plan valid for sixty months ☐ Authorization to Construct is valid for a period equal to that of Improvement Permit – not to exceed sixty months.

Signed: date 6-27-07 Installed by:

Improvement Permit by: Maint Tech Olson RS date 6/26/07 Operation Permit by: date

Authorization to Construct by: Maint Tech Olson RS date 6/26/07 Existing System Inspection by: Maint Tech Olson RS date 6/26/07

HEALTH DEPT. COPY: WHITE OWNER COPY (FINAL): YELLOW OWNER COPY (INITIAL): PINK

Pd $100.00

IREDELL COUNTY HEALTH DEPARTMENT

STATESVILLE 704-878-5305 MOORESVILLE 704-664-5281

IMPROVEMENT PERMIT / AUTHORIZATION TO CONSTRUCT / OPERATION PERMIT / EXISTING SYSTEM INSPECTION

16586 50.00 Paid A

PERMIT# ~~16587~~ PIN# 4645 28 1746 DATE 1/19/01

OWNER OR CONTRACTOR Dave White PHONE: Business Home 464-2115

ADDRESS PO Box 117 Mt. Mourne, NC. 28123

LOCATION Templeton Rd. TR Lynn Cove Rd. to 6th lot on (L)

SUBDIVISION MORGAN LANDING BLOCK / SECTION LOT 6 LOT AREA 21780 FT² SITE CLASS. RS DESIGN FLOW 360 L.T.A.R. .3

Septic Tank: 1000 Gallons: STB 794 Date 8/23/99
Pump Tank: Gallons; PT Date
Pump Make: Model Serial No.
Nitrification Field: No Fields 1 Square Feet 900 * Linear Feet 300 *
No Lines 4@75' Trench Width 3' Max Trench Bottom Depth 3'

[X] New System [ ] Repair System Type: I, II, (III), IV, V, VI
System Description: GRAV - Type 3
Repair System Description: 16" PPBPS
Maintenance Agreement Required: [ ] Yes [X] No
Gravel Depth SAND.

[X] House/Mod. Home No. Bedrooms 3
[ ] Mobile Home No. Bathrooms 3
[ ] Business No. Employees
[ ] Other
[ ] Slab [ ] Crawl Space [ ] Basement w/plumbing [ ] Basement wo/plumbing


Water Supply: [X] Individual [ ] Public [ ] Community

Comments:/Conditions:

Poor Perc for Area

(1" = 40')

INITIAL SITE SKETCH

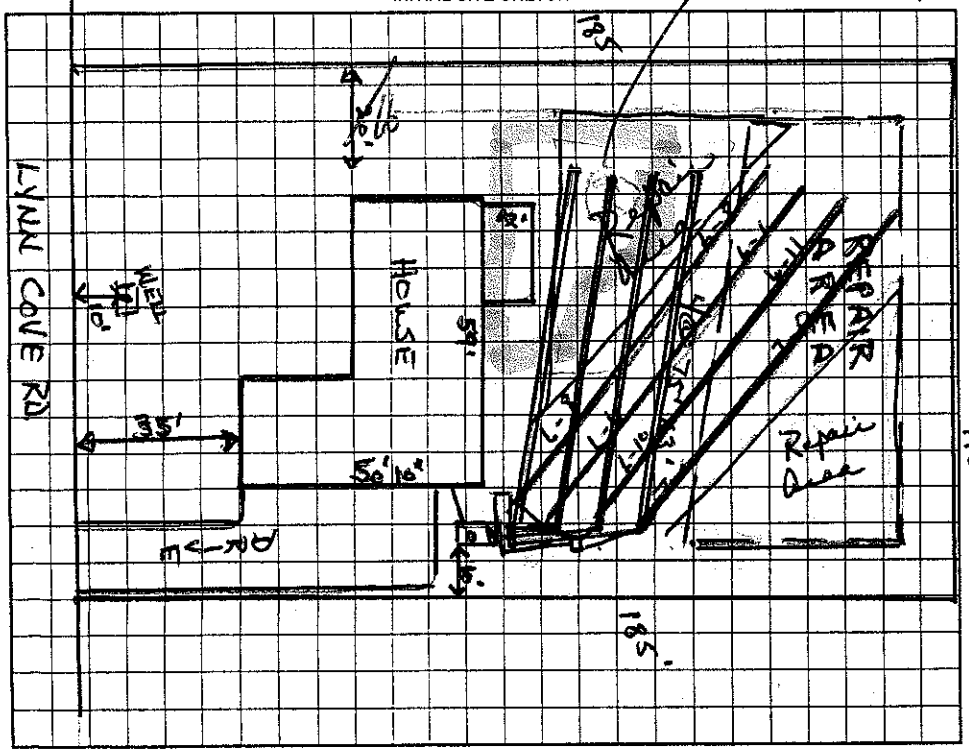

AS BUILT SKETCH

* How drainlines were installed

Permit can be suspended or revoked if any false information is supplied toward securing the permit/any unauthorized changes are made to the site/any unauthorized changes are made in the installation of the system. Improvement Permit with plat valid without expiration. Improvement Permit with site plan valid for sixty months. Authorization to Construct is valid for a period equal to that of Improvement Permit – not to exceed sixty months.

Signed: * date 1/26/01 Installed by: Curt Dunning

Improvement Permit by: Wesley Sparks RS. date 1/19/01 Operation Permit by: Wesley Sparks RS. date 9/27/01

Authorization to Construct by: Wesley Sparks RS. date 1/19/01 Existing System Inspection by: date

HEALTH DEPT COPY-WHITE OWNER COPY (FINAL)-YELLOW OWNER COPY (INITIAL)-PINK