IREDELL COUNTY HEALTH DEPARTMENT

STATESVILLE 704-878-5305 4645283894 MOORESVILLE 704-664-5281

IMPROVEMENT PERMIT / CERTIFICATE OF COMPLETION / OPERATION PERMIT / EXISTING SYSTEM INSPECTION

PROPERTY DESCRIPTION NO. 21282 DATE 6/7/95 TAX MAP NO. 26 21 A 14 Watershed: ☐ Yes ☒ No

OWNER OR CONTRACTOR John + Sherri Cuevas PHONE: Business _____ Home 455-6049

ADDRESS 548 Leathers Wood Ln. Harris burg, NC. 28075

LOCATION _____

SUBDIVISION Morgan Landing BLOCK / SECTION 1 LOT 14 LOT AREA 2.55 AC SITE CLASS. P DESIGN FLOW ~~440~~ 360 AWS L.T.A.R. .3 AWS

Septic Tank: 1000 Gallons; STB 797 Date 1200

Pump Tank: _____ Gallons; PT _____ Date _____

Pump Make: _____ Model _____ Serial No. 300 ~~440~~ AWS

Nitrification Field: No Fields 1 Square Feet ~~1600~~ Linear Feet ~~533~~

No Lines ~~5~~ 5 AWS Trench Width 36" Max Trench Bottom Depth 36" Gravel Depth N/A

☒ New System ☐ Repair System Type: I, II, ☒ III, IV, V, VI

System Description: ~~GRAY~~ GRAY INFILTRATOR

Repair System Description: Pressure Panel

Maintenance Agreement Required: ☐ Yes ☒ No

☒ House/Mod. Home No. Bedrooms ~~3~~ 3

☐ Mobile Home No. Bathrooms 3

☐ Business No. Employees _____

☐ Other _____


☐ Slab ☐ Crawl Space ☐ Basement w/plumbing ☐ Basement wo/plumbing

Water Supply: ☒ Individual ☐ Community ☐ Public


Comments:
1500 SFT w/ GARBAGE DISPOSAL

Comments: ~~Changes on this~~ Changed 8/2/96 - AWS
Changed plan to 330. from 440.

INITIAL SITE SKETCH

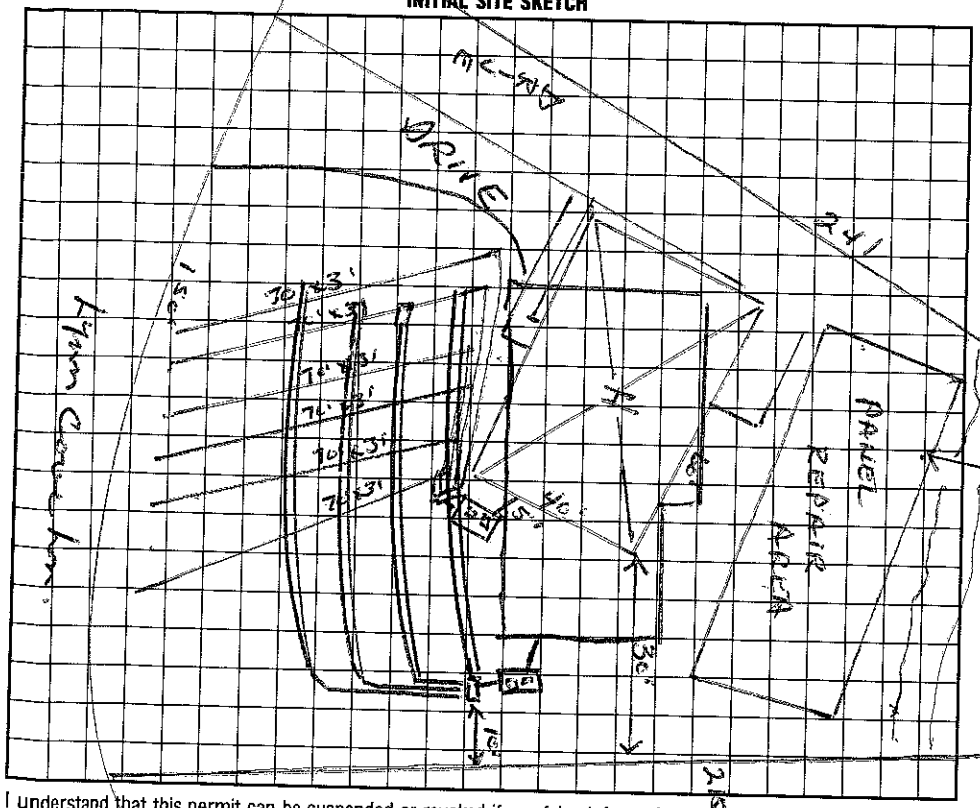

AS BUILT SKETCH

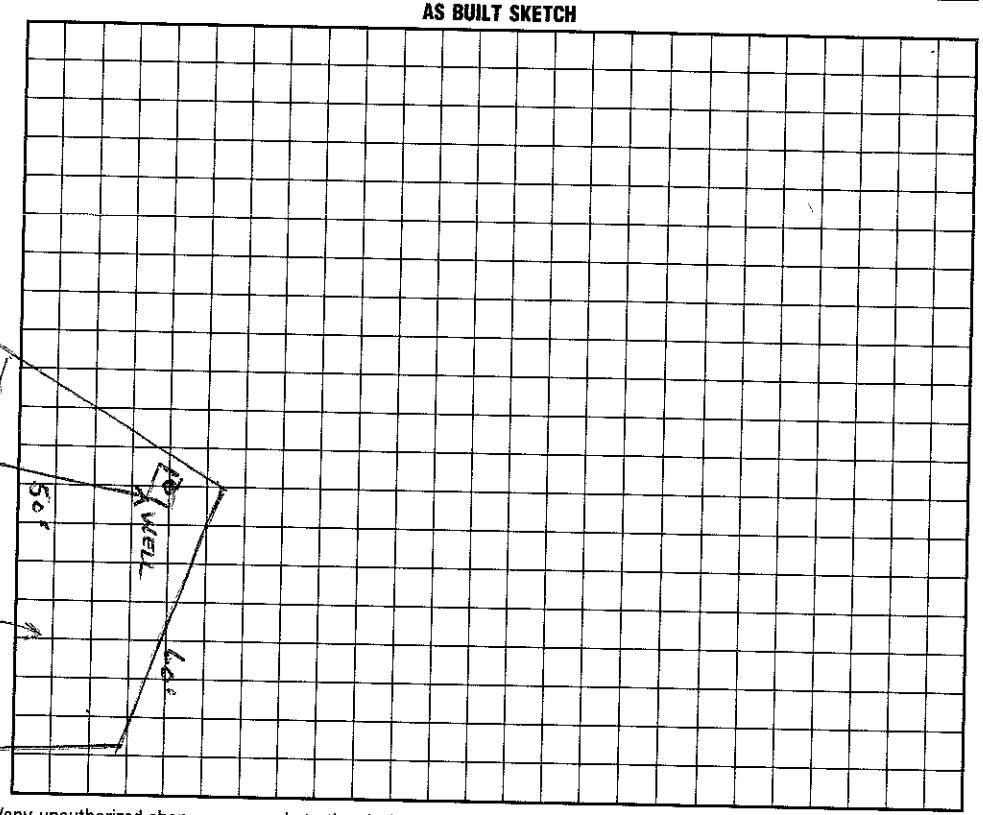

I understand that this permit can be suspended or revoked if any false information is supplied toward securing the permit/any unauthorized changes are made to the site/any unauthorized changes are made in the installation of the system. Improvement Permit is valid for 60 months from date of issuance.

Signed: ~~Shawn Cuevas~~

Improvement Permit by: Wesley Sparks R.S. date 6/7/95

Existing System Inspection by: _____ date _____

Installed by: Curt Dunning

Certificate of Completion by: _____ date _____

Operation Permit by: Wesley Sparks R.S. date 1/6/97

HEALTH DEPT. COPY: WHITE INSPECTION COPY (FINAL): GREEN OWNER COPY (FINAL): YELLOW INSPECTION COPY (INITIAL): PINK OWNER COPY (INITIAL): GOLD