IREDELL COUNTY HEALTH DEPARTMENT

STATESVILLE 704-878-5305 MOORESVILLE 704-664-5281

IMPROVEMENT PERMIT / CERTIFICATE OF COMPLETION / OPERATION PERMIT / EXISTING SYSTEM INSPECTION

PROPERTY DESCRIPTION NO. 21281 DATE 6/21/95 TAX MAP NO. 2C 21 A 13 Watershed: ☐ Yes ☒ No

OWNER OR CONTRACTOR RAY KELLY PHONE: Business 4645-28-4944 Home 892-3556

ADDRESS PO BOX 117 MT MOURNE, NC 28123

LOCATION ALCOVE TR TEMPLETON (R) AT TREE TR LYNNCOVE TO NEXT TO LAST LOT ON (R) 360 NWS

SUBDIVISION MORGAN LANDING BLOCK / SECTION ____ LOT 13 LOT AREA ~1.65 AC SITE CLASS. P DESIGN FLOW ~~480~~ 360 L.T.A.R. .3

Septic Tank: 1000 Gallons; STB 994 Date 12/8/95

Pump Tank: ____ Gallons; PT ____ Date ____

Pump Make: ____ Model 1200 Serial No. 300'

Nitrification Field: No Fields 1 Square Feet ~~1200~~ Linear Feet ~~360~~

No Lines 4 Trench Width ~~36"~~ 24" Max Trench Bottom Depth 32" Gravel Depth 6" SAND

☒ New System ☐ Repair System Type: I, II, (III), IV, V, VI

System Description: GRAV PANEL

Repair System Description: SAME

Maintenance Agreement Required: ☐ Yes ☒ No

☒ House/Mod. Home ☐ Mobile Home ☐ Business ☐ Other

No. Bedrooms 4 No. Bathrooms 3.5 No. Employees ____

Water Supply: ☒ Individual ☐ Community ☐ Public

☒ Slab ☒ Crawl Space ☐ Basement w/plumbing ☐ Basement wo/plumbing


Comments:

VERY TIGHT - CHANGE WILL INVOLVE PRESSURE DISTRIBUTION. CALL H.D. BEFORE CHANGING ANYTHING 12/13/95 300'

Comments:

12/26/95 Changed to 300' of gravity installation running from house toward Hyden Creek Rd. NWS

INITIAL SITE SKETCH

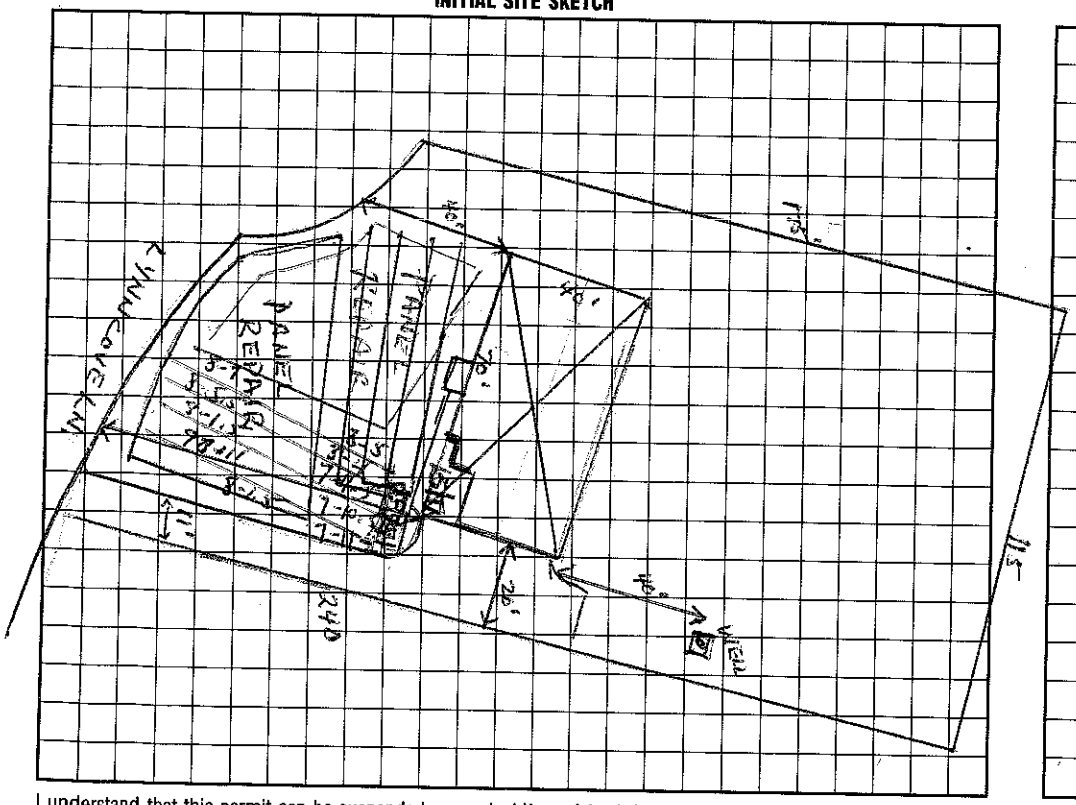

AS BUILT SKETCH

I understand that this permit can be suspended or revoked if any false information is supplied toward securing the permit/any unauthorized changes are made to the site/any unauthorized changes are made in the installation of the system. Improvement Permit is valid for 60 months from date of issuance.

Signed: Ray Kelly

Improvement Permit by: Wesley Sparks R.S. date 6/21/95

Existing System Inspection by: ____ date ____

Installed by: Brad Rumbo

Certificate of Completion by: ____ date ____

Operation Permit by: Wesley Sparks R.S. date 1/24/96

HEALTH DEPT. COPY: WHITE INSPECTION COPY (FINAL): GREEN OWNER COPY (FINAL): YELLOW INSPECTION COPY (INITIAL): PINK OWNER COPY (INITIAL): GOLD