IREDELL COUNTY HEALTH DEPARTMENT

STATESVILLE 704-878-5305 MOORESVILLE 704-664-5281

IMPROVEMENT PERMIT / CERTIFICATE OF COMPLETION / OPERATION PERMIT / EXISTING SYSTEM INSPECTION

PROPERTY DESCRIPTION NO. 16686 DATE Sept. 13, '93

OWNER OR CONTRACTOR Robert W. Phillips PHONE: Business 645-29-1357 TAX MAP NO. 264C23

ADDRESS 15500 Hwy 73, Huntersville Home

LOCATION 1206 (Alydar) TR 1108 (Templeton) to end TR Henry Lane TR Keats At end on Right

SUBDIVISION Kelly Cove BLOCK / SECTION LOT 13 LOT AREA 1.68 Ac SITE CLASS. PS L.T.A.R. .03

Water Supply: ☑ Individual ☐ Community ☐ Public

Septic Tank: 1000 Gallons; STB. 358 ACP Date 12-1-93

Pump Tank: Gallons; PT Date

Nitrification Field: No Fields 2 Square Feet 1620 Linear Feet 540

No Lines 7 (14) Trench Width 36" Trench Depth 36"* Gravel Depth 12"

☑ New System ☐ Repair System Type: I, II, III, IV, V, VI

System Description: 2 gravel conventional

Repair System Description: pumped conv. w/PVBPS

Maintenance Agreement Required: ☐ Yes ☐ No

☑ House/Mod. Home No. Bedrooms 4

☐ Mobile Home No. Bathrooms 3

☐ Business No. Employees

☐ Other

☐ Slab ☑ Crawl Space ☐ Basement w/plumbing ☐ Basement wo/plumbing

Garbage Disposal: ☑ Yes ☐ No


Auto. Dishwasher: ☑ Yes ☐ No

Auto. Washing Machine: ☑ Yes ☐ No


Other

Comments * Trenches shown on diagram are not on exact contours. They may require step downs; owner desires to do this in order to install conventional system. 2 subfields of 270' each required.

INITIAL SITE SKETCH

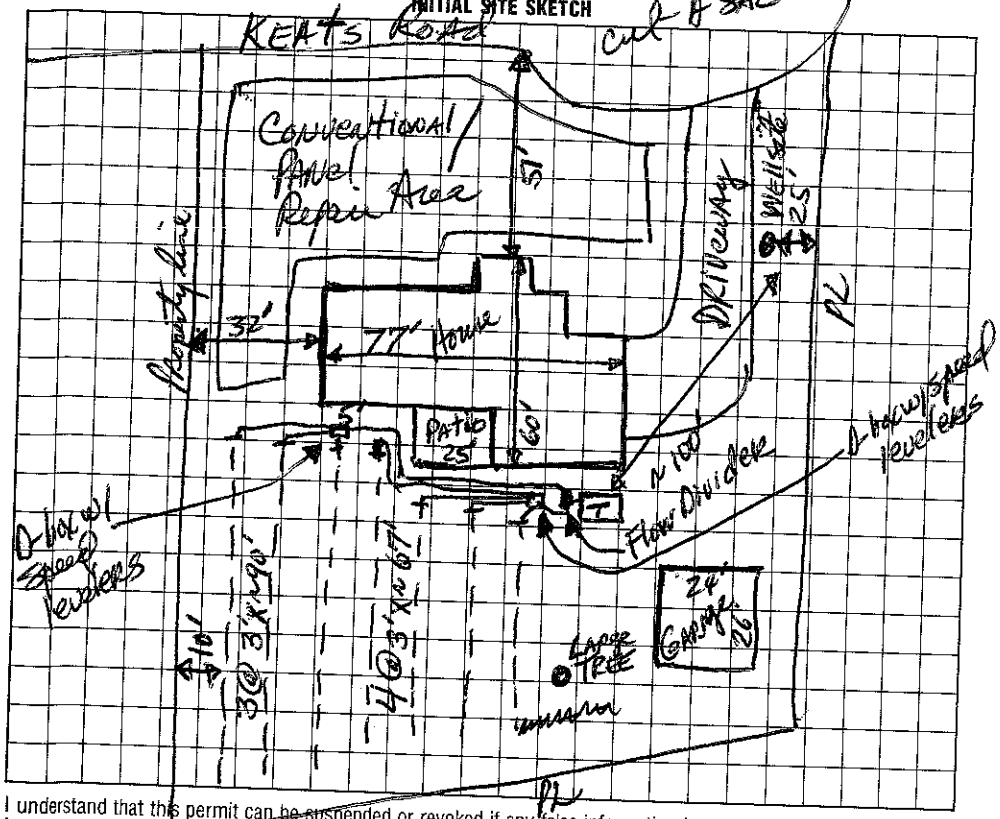

AS BUILT SKETCH

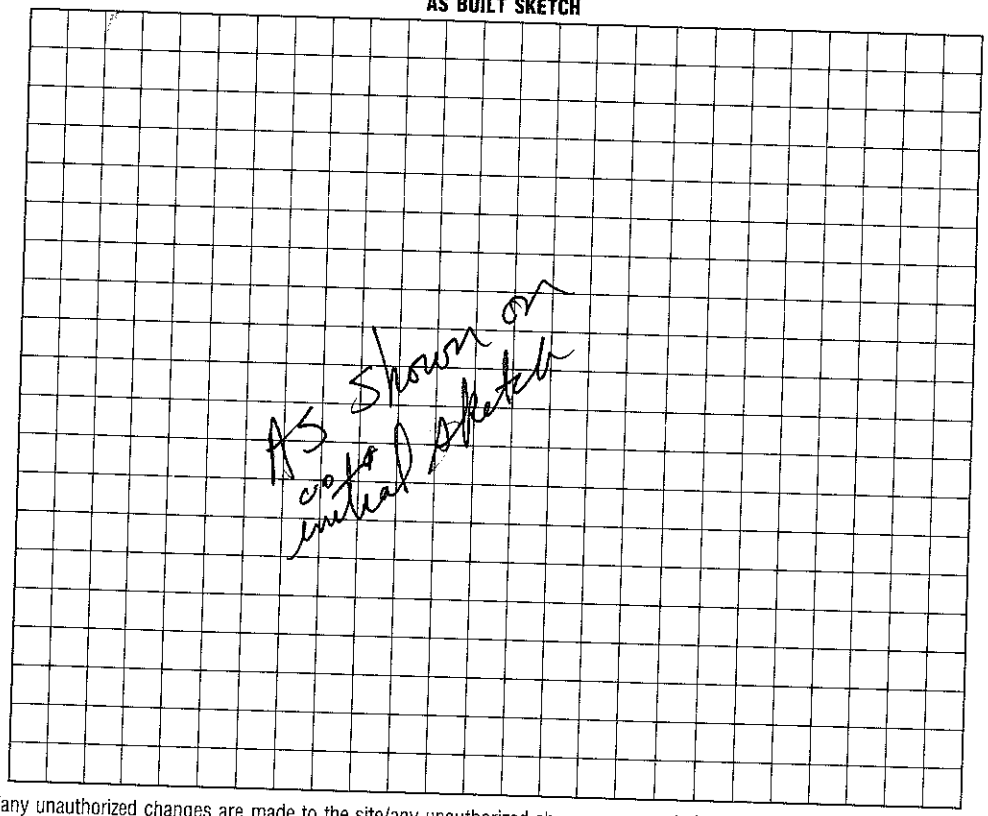

I understand that this permit can be suspended or revoked if any false information is supplied toward securing the permit/any unauthorized changes are made to the site/any unauthorized changes are made in the installation of the system. Improvement Permit is valid for 60 months from date of issuance.

Signed: Robert W. Phillips

Improvement Permit by: David R. Hanson, RS date Sept 13 '93

Existing System Inspection by: date

Installed by: Owner

Certificate of Completion by: David R. Hanson, RS date Feb 1, '94

Operation Permit by: date

HEALTH DEPT. COPY: WHITE INSPECTION COPY (FINAL): GREEN OWNER COPY (FINAL): YELLOW INSPECTION COPY (INITIAL): PINK OWNER COPY (INITIAL): GOLD