IREDELL COUNTY HEALTH DEPARTMENT

STATESVILLE 704-878-5305 MOORESVILLE 704-664-5281

IMPROVEMENT PERMIT / ~~CERTIFICATE OF COMPLETION~~ / OPERATION PERMIT / EXISTING SYSTEM INSPECTION

PROPERTY DESCRIPTION NO. 24266 DATE 7/19/96 TAX MAP NO. 2G 4A 13 Watershed: ☒ Yes ☐ No

OWNER OR CONTRACTOR Ken Koontz ~~PHONE: Business~~ 4645-29-1357 Home 662-6556

ADDRESS 191 Keats Rd. Mooresville, NC. 28115

LOCATION Hennyton - Alcove Rd TR Templeton, Rt. Tree TR Hennyton, 3RD lot on (L) past Bobwhite Ln.

SUBDIVISION Kelly Cove BLOCK / SECTION ____ LOT 13 LOT AREA .679 SITE CLASS PS DESIGN FLOW 360 L.T.A.R. .3

Septic Tank: 1250 Gallons; STB 794 Date 11/13/96

Pump Tank: ____ Gallons; PT ____ Date ____

Pump Make: ____ Model ____ Serial No. ____

Nitrification Field: No Fields 1 Square Feet 1200 Linear Feet *300

No Lines 4 Trench Width 36" Max Trench Bottom Depth 36" Gravel Depth SAND

☒ New System ☐ Repair System Type: I, II, (III) IV, V, VI

System Description: *6R. CH. PLASTIC

Repair System Description: SAME

Maintenance Agreement Required: ☐ Yes ☒ No

☒ House/Mod. Home No. Bedrooms 3

☐ Mobile Home No. Bathrooms 2.5

☐ Business No. Employees ____

☒ Other GARBAGE DISPOSAL


☐ Slab ☒ Crawl Space ☐ Basement w/plumbing ☐ Basement wo/plumbing

Water Supply: ☒ Individual ☐ Community ☐ Public


Comments: if front Utility Easement encroaches then adjust house back further.

Comments:

INITIAL SITE SKETCH

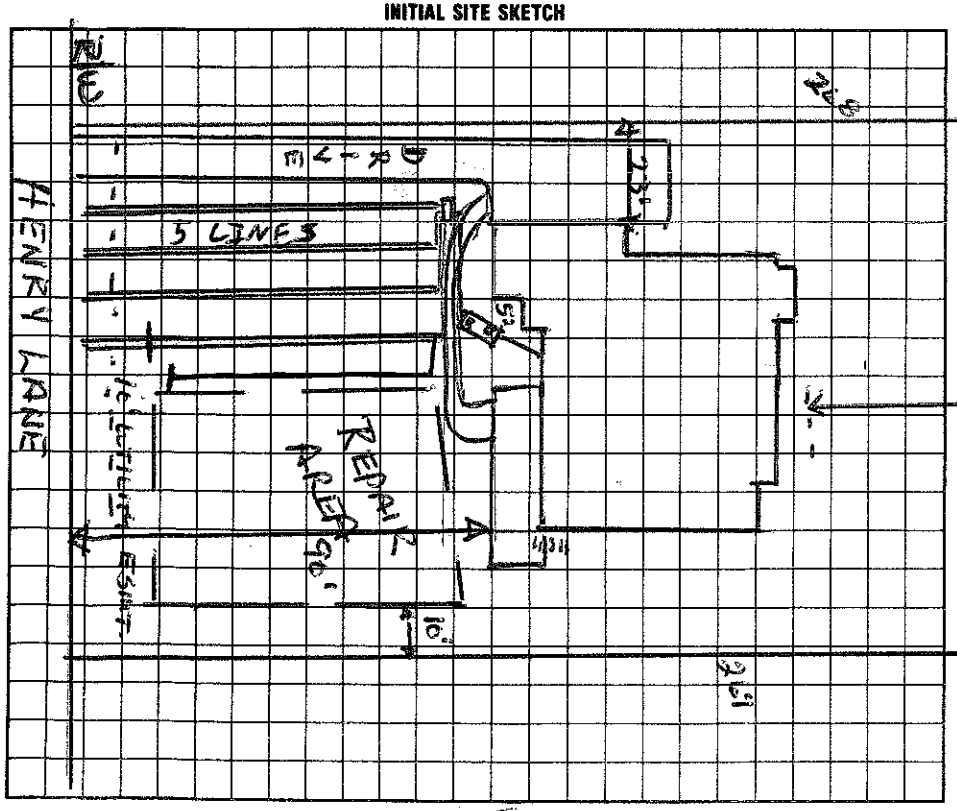

AS BUILT SKETCH

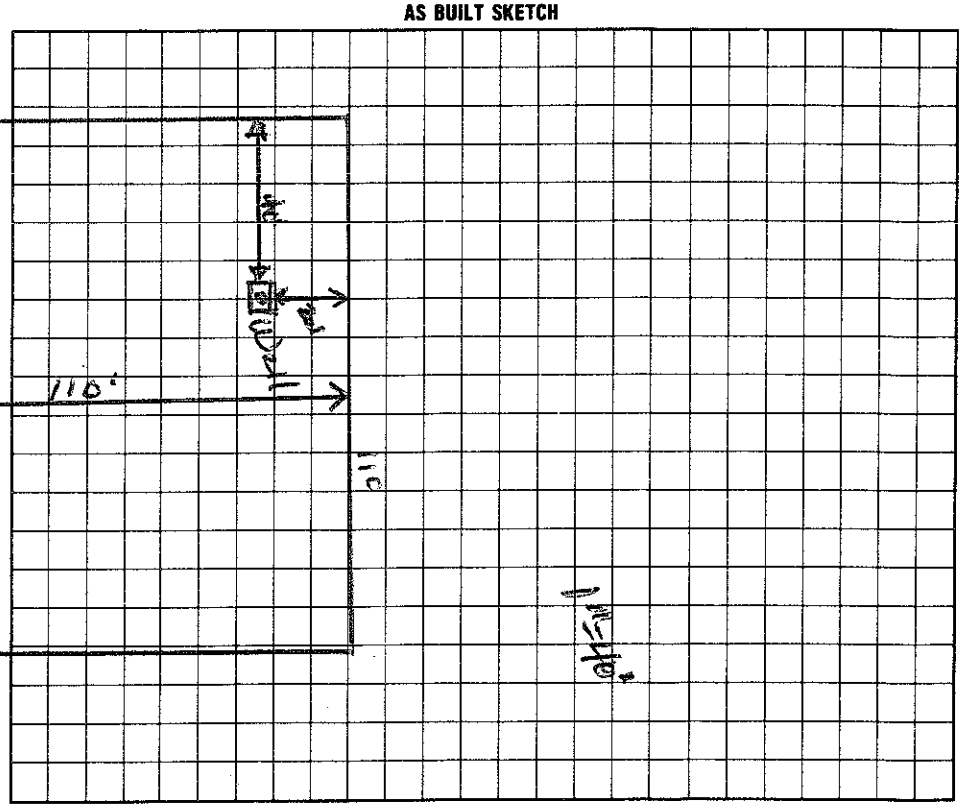

I understand that this permit can be suspended or revoked if any false information is supplied toward securing the permit/any unauthorized changes are made to the site/any unauthorized changes are made in the installation of the system.

Signed: ~~K. Koontz~~ Authorization for Construct indefinitely valid

Improvement Permit by: Wesley Sparks R.S. date 7/19/96

Existing System Inspection by: Wesley Sparks R.S. date 7/19/96

Installed by: BARRY THOMPSON

Certificate of Completion by: ____ date ____

Operation Permit by: C. [illegible] EHSI date 2/19/97

HEALTH DEPT. COPY: WHITE INSPECTION COPY (FINAL): GREEN OWNER COPY (FINAL): YELLOW INSPECTION COPY (INITIAL): PINK OWNER COPY (INITIAL): GOLD