(9:30)

IREDELL COUNTY HEALTH DEPARTMENT

STATESVILLE 704-878-5305 MOORESVILLE 704-664-5281

IMPROVEMENT PERMIT / CERTIFICATE OF COMPLETION / OPERATION PERMIT / EXISTING SYSTEM INSPECTION

PROPERTY DESCRIPTION NO. 21382 DATE 7/22/95 TAX MAP NO. 2G 21 A 9 Watershed: [X] Yes [ ] No

OWNER OR CONTRACTOR Boyden Zwendt PHONE: Business 464-20-2103 Home 599-0765

ADDRESS 9301 Pebble Creek Way Char. NC. 28269

LOCATION Templeton (R) at the (R) on Lynncove at culdesac on (L)

SUBDIVISION Morgans Landg. BLOCK / SECTION 1 LOT 9 LOT AREA .89 SITE CLASS. PS DESIGN FLOW 360 L.T.A.R. .3

Septic Tank: 1000 Gallons; STB _____ Date _____

Pump Tank: _____ Gallons; PT _____ Date _____

Pump Make: _____ Model 400 Serial No. 300

Nitrification Field: No Fields 1 Square Feet 1200 Linear Feet 400

No Lines 4 @ 3 Trench Width 36" Max Trench Bottom Depth 36" Gravel Depth 12"

[X] New System [ ] Repair System Type: I (II) III IV, V, VI

System Description: CONV. - DIST BOX

Repair System Description: Chambered

Maintenance Agreement Required: [ ] Yes [ ] No

[X] House/Mod. Home No. Bedrooms 3

[ ] Mobile Home No. Bathrooms 2.5

[ ] Business No. Employees ____

[ ] Other ____


[ ] Slab [X] Crawl Space [ ] Basement w/plumbing [ ] Basement wo/plumbing

Water Supply: [X] Individual [ ] Community [ ] Public


Comments: CHANGED TO CHAMBERED PER WESLEY SPARKS

Comments:

INITIAL SITE SKETCH

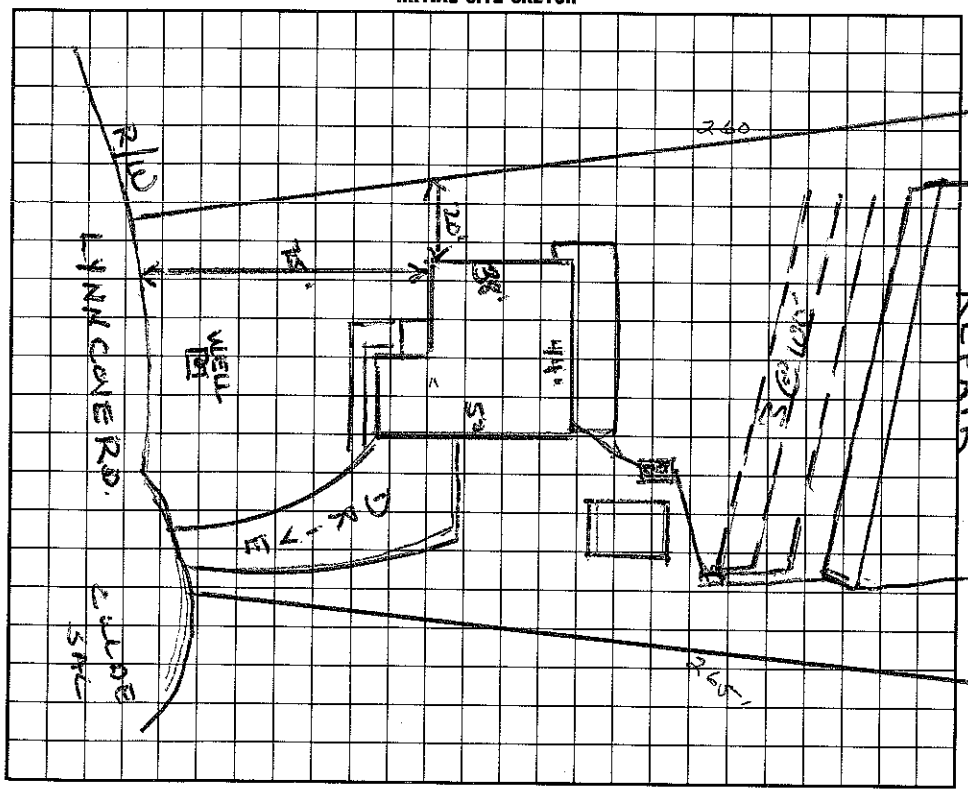

AS BUILT SKETCH

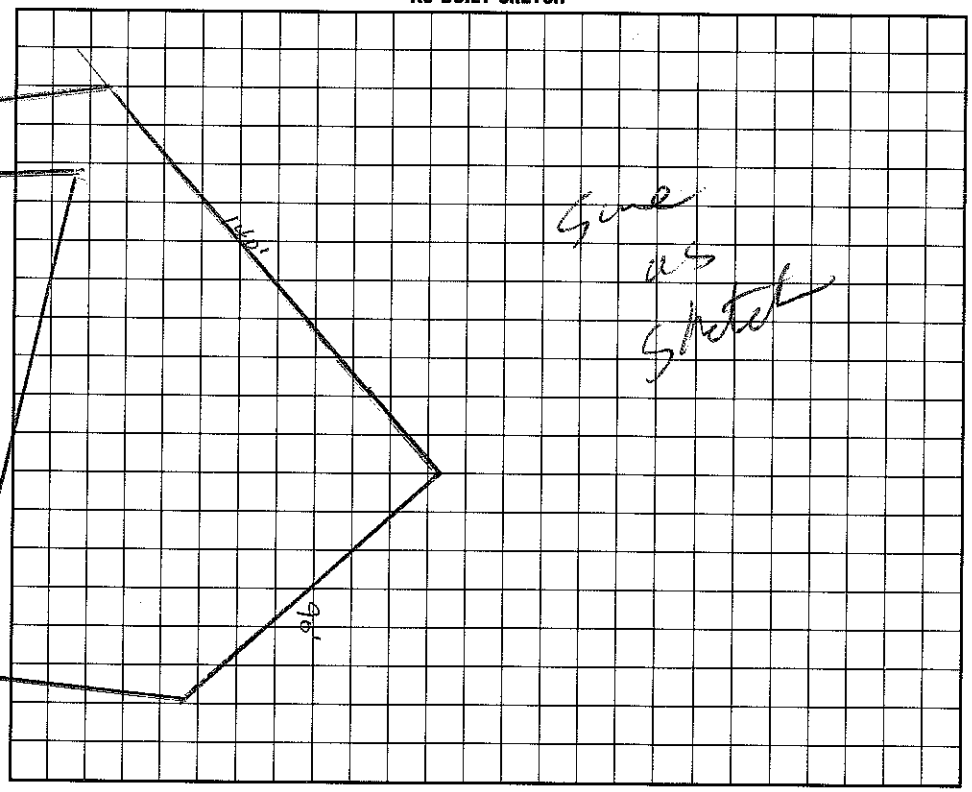

I understand that this permit can be suspended or revoked if any false information is supplied toward securing the permit/any unauthorized changes are made to the site/any unauthorized changes are made in the installation of the system. Improvement Permit is valid for 60 months from date of issuance.

Signed: _____

Improvement Permit by: Wesley Sparks RS. date 7/22/95

Existing System Inspection by: Wesley Sparks RS date 9/15/97

Installed by: MAYHEW SEPTIC

Certificate of Completion by: _____ date _____

Operation Permit by: C. Rudy Jones date 10/21/97

HEALTH DEPT. COPY: WHITE INSPECTION COPY (FINAL): GREEN OWNER COPY (FINAL): YELLOW INSPECTION COPY (INITIAL): PINK OWNER COPY (INITIAL): GOLD