IREDELL COUNTY HEALTH DEPARTMENT

STATESVILLE 704-878-5305 MOORESVILLE 704-664-5281

4645-29-2832

IMPROVEMENT PERMIT / CERTIFICATE OF COMPLETION / OPERATION PERMIT / EXISTING SYSTEM INSPECTION

PROPERTY DESCRIPTION NO. 14466 DATE August 23, 93 TAX MAP NO. 2G 4C5

OWNER OR CONTRACTOR Kenneth A. Koontz PHONE: Business _____ Home (704) 549-4106

ADDRESS 4521 Quail Ridge Dr. Charlotte, NC 28227

LOCATION Alcove Rd. 4R 1108 (Templeton) Bear Right at Oak Tree Keep Right Near End of Keats Rd. on left

SUBDIVISION ~~Kelly Boyd~~ HENRY MOORE KELLY BLOCK / SECTION _____ LOT 5 LOT AREA ± 1.6 Ac SITE CLASS 5 Apr 1956 L.T.A.R. .3 gal/ft²/day

Water Supply: ☑ Individual ☐ Community ☐ Public

Septic Tank: 1000 Gallons; STB 794 Date 4/14/94

Pump Tank: 1000 Gallons; PT 27 Date 11/7/93

Nitrification Field: No. Fields 1 Square Feet _____ Linear Feet 200

No. Lines ± 5 Trench Width 24" Trench Depth ± 30" Gravel Depth NA

☑ New System ☐ Repair System Type: I, II, III, (IV), V, VI

System Description: LP pipes

Repair System Description: Same

Maintenance Agreement Required: ☑ Yes ☐ No

☑ House/Mod. Home ☐ Mobile Home ☐ Business ☐ Other _____

No. Bedrooms 3 No. Bathrooms 2½ No. Employees _____

☐ Slab ☑ Crawl Space ☐ Basement w/plumbing ☐ Basement wo/plumbing

Garbage Disposal: ☑ Yes ☐ No


Auto. Dishwasher: ☑ Yes ☐ No

Auto. Washing Machine: ☑ Yes ☐ No

Other _____

Comments 4 lo panels total, 1¼" sch 40 through panels with one 3/16" hole per panel turned dwn; 2' pressure head. Pump Specs: 28 gal/min at Approx. 20' head.

INITIAL SITE SKETCH

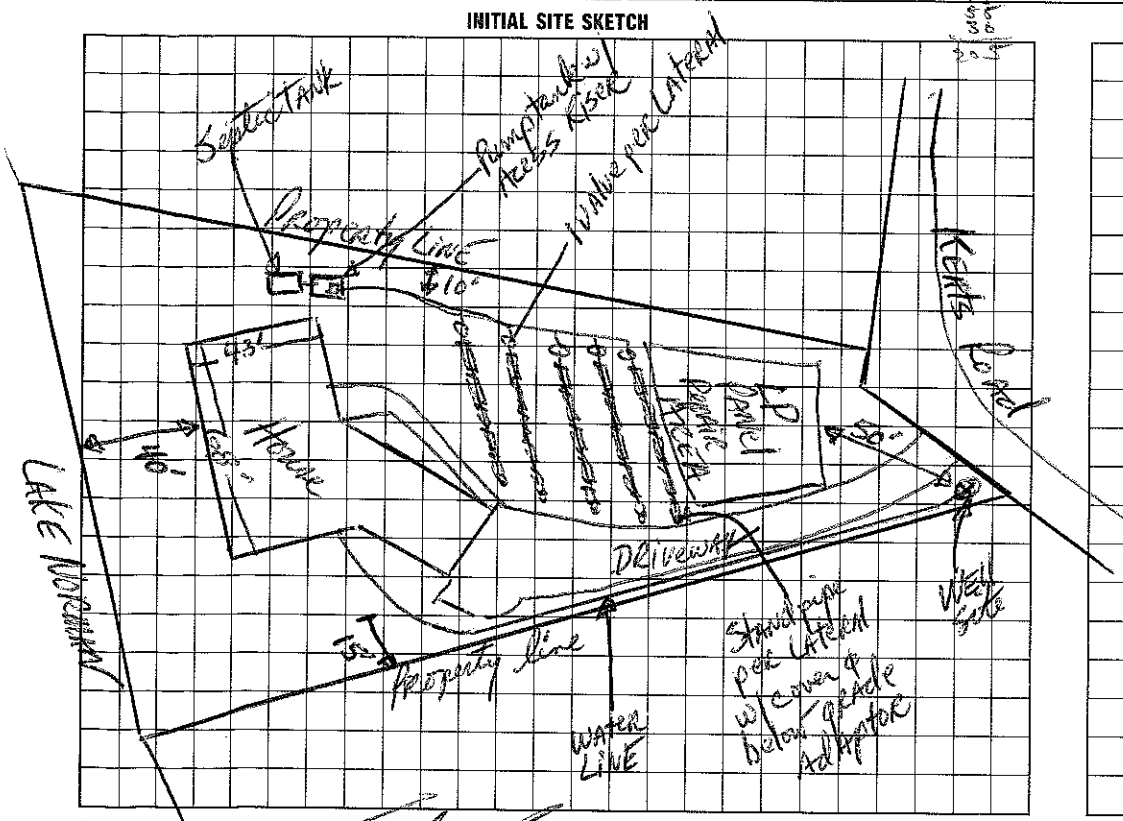

AS BUILT SKETCH

I understand that this permit can be suspended or revoked if any false information is supplied toward securing the permit/any unauthorized changes are made to the site/any unauthorized changes are made in the installation of the system. Improvement Permit is valid for 60 months from date of issuance.

Signed: [signature]

Improvement Permit by: [signature] RS date 5/23/93

Existing System Inspection by: _____ date _____

Installed by: Julian Bowles

Certificate of Completion by: Wesley Sparks RS. date 6/17/94

Operation Permit by: Wesley Sparks RS. date 6/17/94

HEALTH DEPT. COPY: WHITE INSPECTION COPY (FINAL): GREEN OWNER COPY (FINAL): YELLOW INSPECTION COPY (INITIAL): PINK OWNER COPY (INITIAL): GOLD