IREDELL COUNTY HEALTH DEPARTMENT

STATESVILLE 704-878-5305 MOORESVILLE 704-664-5281

IMPROVEMENT PERMIT / AUTHORIZATION TO CONSTRUCT / OPERATION PERMIT / EXISTING SYSTEM INSPECTION

2:00

PERMIT# 18707 PIN# 4645294179 DATE 1/12/98

OWNER OR CONTRACTOR Jim Basinger PHONE: Business Home 948-0451

ADDRESS 7503 Bullwater Cove Huntersville, NC 28078

LOCATION Alcove Rd TR Templeton Rd. TR Lynn Cove Lane to last lot off cul de sac

SUBDIVISION MORGAN LANDING BLOCK / SECTION LOT 11 LOT AREA 1.56 AC SITE CLASS. PS DESIGN FLOW 480 L.T.A.R. .25

Septic Tank: 1000 Gallons; STB 1012 Date 9/6/99

Pump Tank: Gallons; PT Date

Pump Make: Model 900 Serial No. 300

Nitrification Field: No Fields 1 Square Feet ~~900~~ Linear Feet ~~300~~

No Lines 3 Trench Width 36" Max Trench Bottom Depth 30" Gravel Depth SAND

☒ New System ☐ Repair System Type: I, II, III, IV, V, VI

System Description: GRAV - ~~PRESSURE~~ HDSOR

Repair System Description: SAME CH. PLAS.

Maintenance Agreement Required: ☐ Yes ☒ No

☒ House/Mod. Home ☐ Mobile Home ☐ Business ☐ Other

No. Bedrooms 3 ~~4~~ No. Bathrooms 3.5 No. Employees


Water Supply: ☒ Individual ☐ Public ☐ Community

☐ Slab ☐ Crawl Space ☒ Basement w/plumbing ☐ Basement wo/plumbing


Comments:/Conditions: 36" WIDE TRENCHES

Comments:/Conditions: 11/22/99 Ashe Hedge presented house plan indicating this is a 3 BRM home — Changed permit to HDSon CH. PLASTIC.

INITIAL SITE SKETCH (1" = 40')

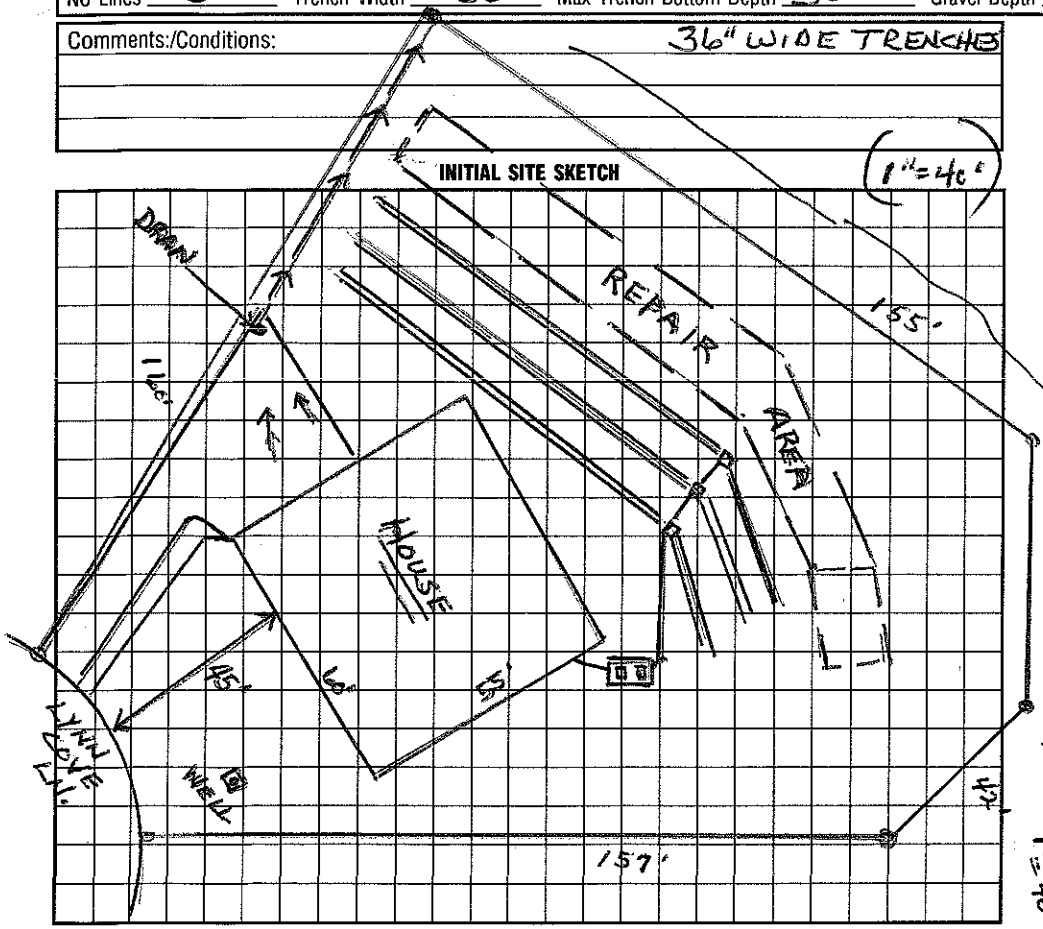

AS BUILT SKETCH

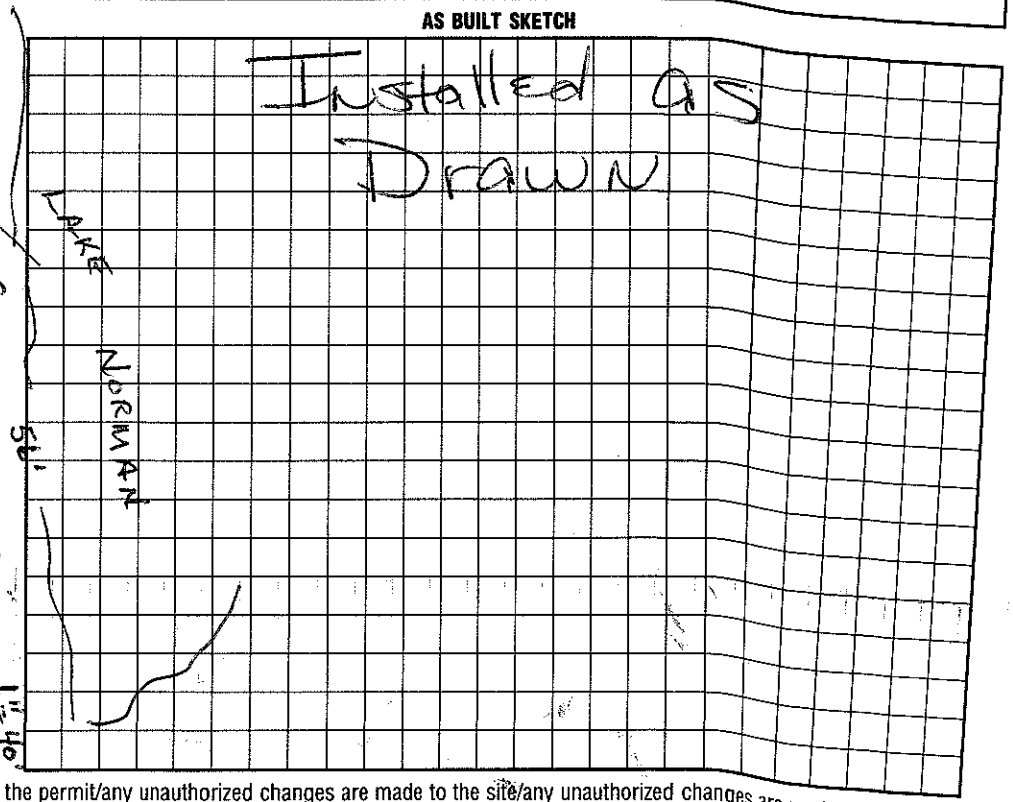

I understand that this permit can be suspended or revoked if any false information is supplied toward securing the permit/any unauthorized changes are made to the site/any unauthorized changes are made in the installation of the system. Improvement Permit with plat valid without expiration. Improvement Permit with site plan valid for sixty months. Authorization to Construct is valid for a period equal to that of Improvement Permit – not to exceed sixty months.

Signed: ~~X~~ [signature] date 1/14/98

Improvement Permit by: Wesley Sparks RS. date 1/12/98

Authorization to Construct by: Wesley Sparks RS. date 1/12/98

Installed by: C & W Grading

Operation Permit by: [signature] RS date 11/30/99

Existing System Inspection by: date

HEALTH DEPT. COPY: WHITE INSPECTION COPY (FINAL): GREEN OWNER COPY (FINAL): YELLOW INSPECTION COPY (INITIAL): PINK OWNER COPY (INITIAL): GOLD