9:3

IREDELL COUNTY HEALTH DEPARTMENT

STATESVILLE 704-878-5305 MOORESVILLE 704-664-5281

IMPROVEMENT PERMIT / CERTIFICATE OF COMPLETION / OPERATION PERMIT / EXISTING SYSTEM INSPECTION

PROPERTY DESCRIPTION NO. 22845 DATE May 29, '97 TAX MAP NO. 2G21A12 Watershed: ☑ Yes ☐ No

OWNER OR CONTRACTOR Robert & Barbara Gandy PHONE: Business Home 645-29-5035

ADDRESS 116 Palisades Ct. Mooresville

LOCATION Templeton Rd. TR Lynn Cove Rd At end

SUBDIVISION Morgan Landing BLOCK / SECTION LOT 12 LOT AREA .5 Ac SITE CLASS PS DESIGN FLOW 480 gpd L.T.A.R. .25

Septic Tank: 1000 Gallons; STB 794 Date 3/11/97

Pump Tank: Gallons; PT Date

Pump Make: Model Serial No.

Nitrification Field: No Fields 1 Square Feet 1440 Linear Feet 480

No Lines 3@160' Trench Width 36" Max Trench Bottom Depth 36" Gravel Depth NA

☑ New System ☐ Repair System Type: I, II, (III), IV, V, VI

System Description: gravity chambered

Repair System Description: gravity Panel Block

Maintenance Agreement Required: ☐ Yes ☑ No

☑ House/Mod. Home No. Bedrooms 4

☐ Mobile Home No. Bathrooms 3½

☐ Business No. Employees

☐ Other


☐ Slab ☐ Crawl Space ☑ Basement w/plumbing ☐ Basement wo/plumbing

Water Supply: ☑ Individual ☐ Community ☐ Public

Comments:
X-ONE Observation / Inspection port per Lateral
This permit replaces permit issued 12-20-95

Comments:
Installed as Shown, except 1 D-Box used instead of Drop boxes.
Inspection ports installed near ends of laterals

INITIAL SITE SKETCH

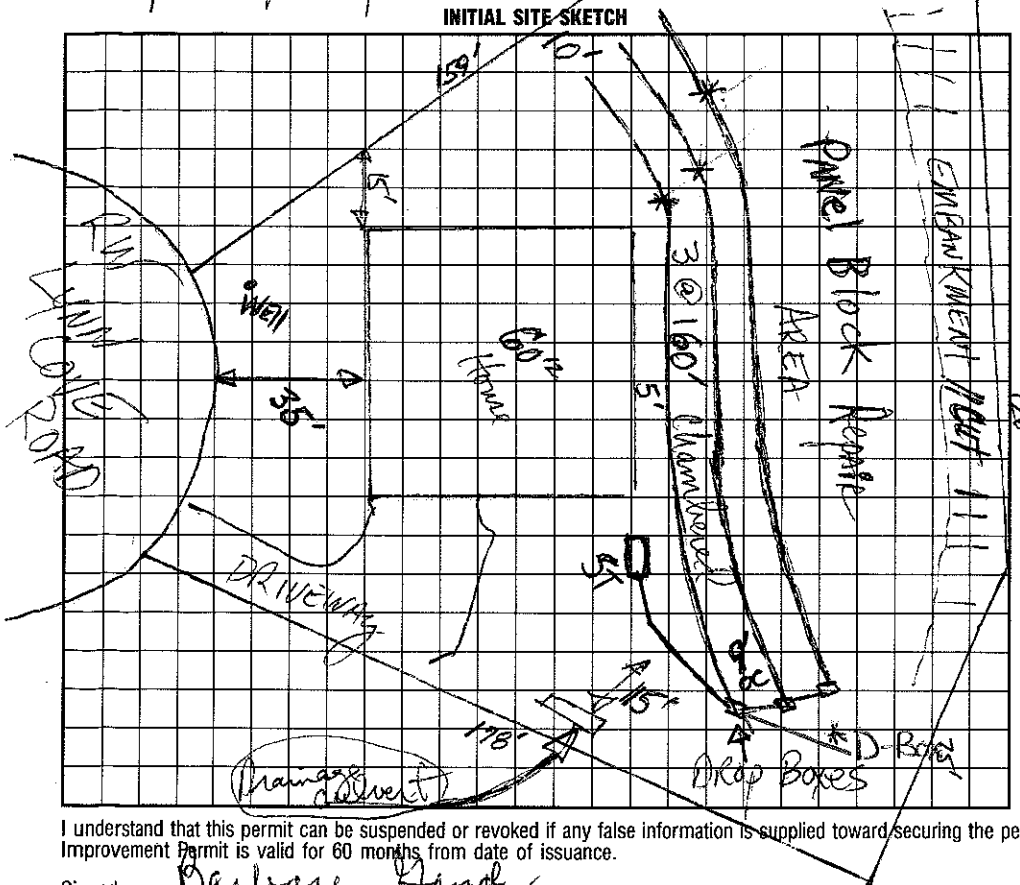

AS BUILT SKETCH

Installed as Shown except for D-Box instead of Drop boxes

I understand that this permit can be suspended or revoked if any false information is supplied toward securing the permit/any unauthorized changes are made to the site/any unauthorized changes are made in the installation of the system. Improvement Permit is valid for 60 months from date of issuance.

Signed: Barbara Gandy

Improvement Permit by: RS date 5-29-97

~~Existing System Inspection~~ Construction Authorization by: RS date 5-29-97

Installed by: Curt Dunning

Certificate of Completion by: ESI date 6/5/97

Operation Permit by: ESI date 6/5/97

HEALTH DEPT. COPY: WHITE INSPECTION COPY (FINAL): GREEN OWNER COPY (FINAL): YELLOW INSPECTION COPY (INITIAL): PINK OWNER COPY (INITIAL): GOLD