IREDELL COUNTY HEALTH DEPARTMENT

STATESVILLE 704-878-5305 MOORESVILLE 704-664-5281

IMPROVEMENT PERMIT / CERTIFICATE OF COMPLETION / OPERATION PERMIT / EXISTING SYSTEM INSPECTION

PROPERTY DESCRIPTION NO. 24272 DATE April 14, 98 TAX MAP NO. part of 2HA17 4645-29-8673 Watershed: ☑ Yes ☐ No

OWNER OR CONTRACTOR Jeffrey & Lisa Mauk PHONE: Business _____ Home _____

ADDRESS P O Box 36508 Charlotte 28236

LOCATION Templeton Rd. TR Quail Ridge TL Sumter Dr. on Right 2nd Cul-d-Sac

SUBDIVISION Templeton Est. BLOCK / SECTION _____ LOT 15 LOT AREA .769 Ac SITE CLASS. PS per 1956 DESIGN FLOW 450 gpd L.T.A.R. .03

Septic Tank: 1000 Gallons; STB 97 Date 9/3/98
Pump Tank: 1000 Gallons; PT 71 Date 10/3/98
Pump Make: MYERS Model ME-3F-11 Serial No. 10/98
Nitrification Field: No Fields 1 Square Feet 560 Linear Feet 280
No Lines 4 Trench Width 24" Max Trench Bottom Depth 30" Gravel Depth NA

☑ New System ☐ Repair System Type: I, II, III, ⓥ, V, VI
System Description: LP Panel Block
Repair System Description: LP Panel Block
Maintenance Agreement Required: ☑ Yes ☐ No

☑ House/Mod. Home No. Bedrooms 4
☐ Mobile Home No. Bathrooms 4
☐ Business No. Employees _____
☐ Other _____
☐ Slab ☑ Crawl Space ☐ Basement w/plumbing ☐ Basement wo/plumbing


Water Supply:
☑ Individual
☐ Community
☐ Public

Comments: LATERALS must be 8' on center


Comments: Drilled WELL Site

1"=60'

INITIAL SITE SKETCH

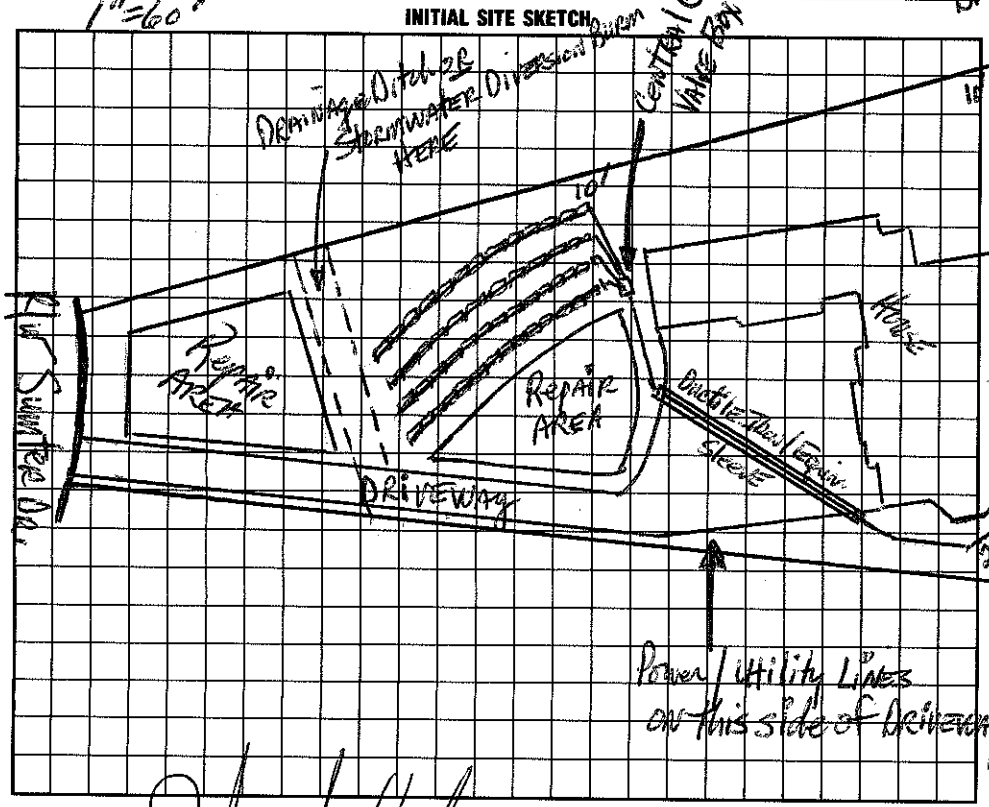

AS BUILT SKETCH

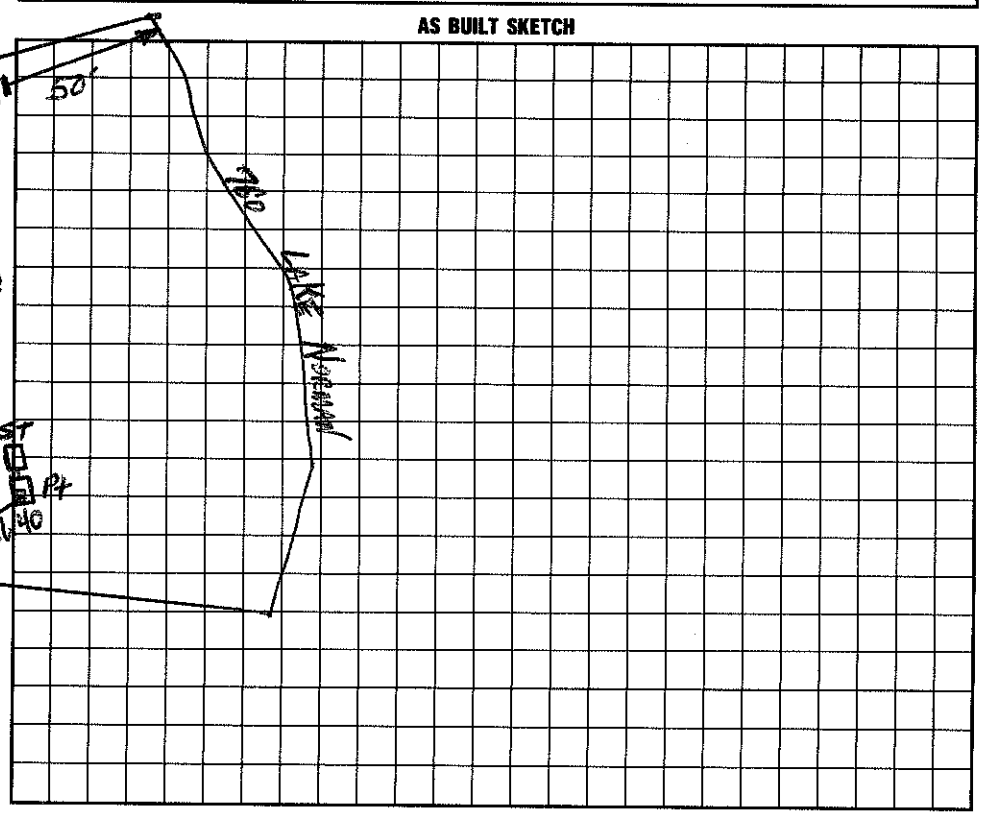

I understand that this permit can be suspended or revoked if any false information is supplied toward securing the permit/any unauthorized changes are made to the site/any unauthorized changes are made in the installation of the system. Improvement Permit is valid for 60 months from date of issuance.

Signed: _____

Improvement Permit by: _____ IRS date 4-14-98

~~Construction Inspection by:~~ Authorized _____ IRS date 4-14-98

Installed by: WT Norwood

Certificate of Completion by: Wesley Sparks R.S. date 4/13/99

Operation Permit by: Wesley Sparks R.S. date 4/13/99

HEALTH DEPT. COPY: WHITE INSPECTION COPY (FINAL): GREEN OWNER COPY (FINAL): YELLOW INSPECTION COPY (INITIAL): PINK OWNER COPY (INITIAL): GO