130 312

IREDELL COUNTY HEALTH DEPARTMENT

STATESVILLE 704-878-5305 MOORESVILLE 704-664-5281

IMPROVEMENT PERMIT / AUTHORIZATION TO CONSTRUCT / OPERATION PERMIT / EXISTING SYSTEM INSPECTION

PERMIT# ~~90508~~ PIN# 4645 29 9287 DATE 7/10/01

OWNER OR CONTRACTOR ~~Tyler Aaron~~ Doug Mann PHONE: Business 704-598-1754 Home

ADDRESS 10802 Alliff Ct Charlotte NC 28213

LOCATION Templeton, R Quail Ridge, L Sumter 9t End

SUBDIVISION Templeton Est. BLOCK / SECTION LOT 19 LOT AREA 0.88 Ac SITE CLASS. PS DESIGN FLOW 480 L.T.A.R. .03

Septic Tank: 1000 Gallons; STB 312 Date 12-8-05

Pump Tank: Gallons; PT Date

Pump Make: Model Serial No.

Nitrification Field: No Fields 1 Square Feet 840 Linear Feet 280

No Lines 8@35' Trench Width 24" or 36" Max Trench Bottom Depth 36" Gravel Depth —

☒ New System ☐ Repair System Type: I, II, (III) IV, V, VI

System Description: Gravity Panel Block

Repair System Description: LP Panel Block

Maintenance Agreement Required: ☐ Yes ☒ No

☒ House/Mod. Home ☐ Mobile Home ☐ Business ☐ Other

No. Bedrooms 4 No. Bathrooms 4 No. Employees

☐ Slab ☒ Crawl Space ☐ Basement w/plumbing ☐ Basement wo/plumbing


Water Supply: ☒ Individual ☐ Public ☐ Community

Comments:/Conditions:


Well may be Less than 100' From Repair Area - GM

Comments:/Conditions: Installed essentially as drawn

INITIAL SITE SKETCH

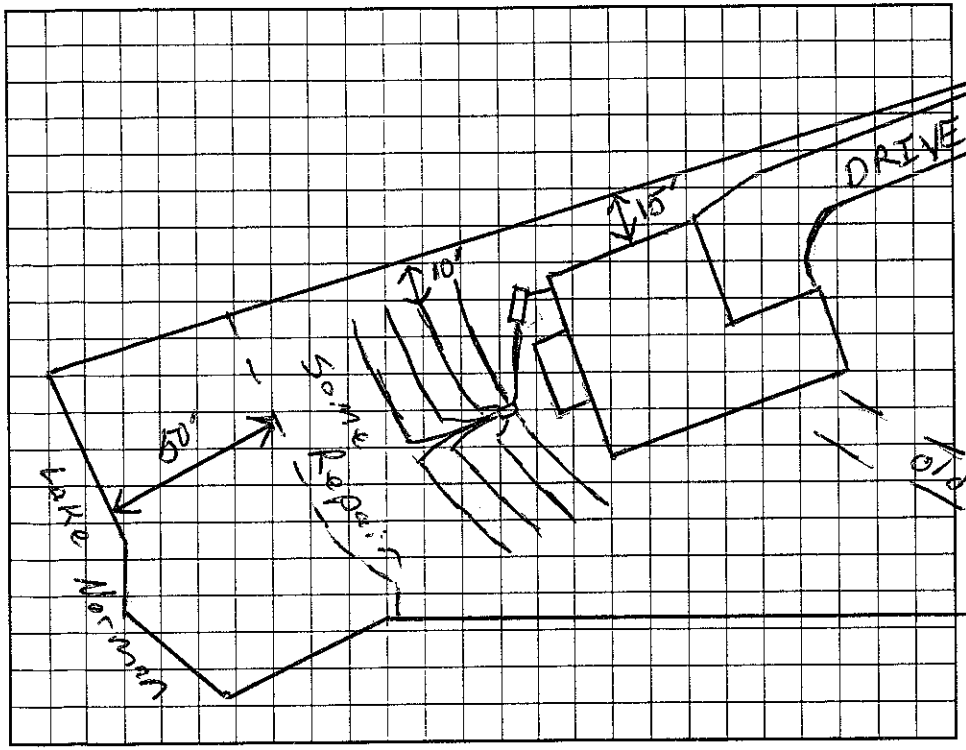

AS BUILT SKETCH

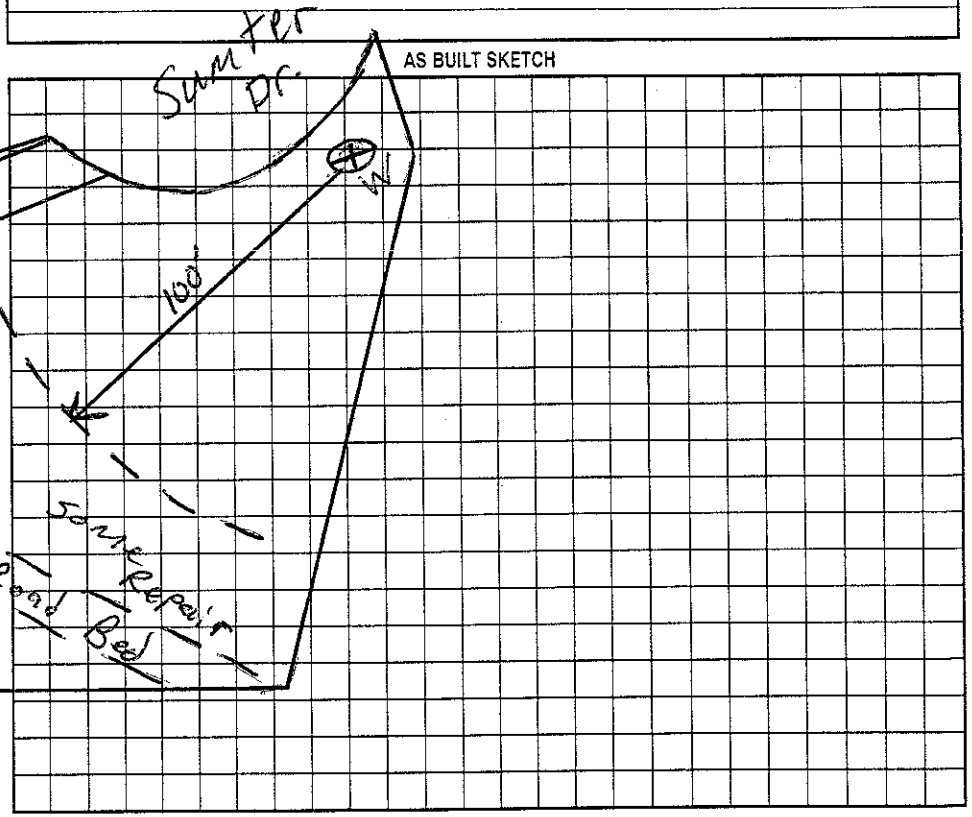

Permit can be suspended or revoked if any false information is supplied toward securing the permit/any unauthorized changes are made to the site/any unauthorized changes are made in the installation of the system. Improvement Permit with plat valid without expiration. Improvement Permit with site plan valid for sixty months. Authorization to Construct is valid for a period equal to that of Improvement Permit - not to exceed sixty months.

Signed: date 7-17-01 Installed by: Bobby Mayhew

Improvement Permit by: RSI date 7/10/01 Operation Permit by: Marvin H. Watson RS date 3/2/06

Authorization to Construct by: RSI date 7/11/01 Existing System Inspection by: date

HEALTH DEPT. COPY: WHITE OWNER COPY (FINAL): YELLOW OWNER COPY (INITIAL): PINK