9.30

IREDELL COUNTY HEALTH DEPARTMENT

Authorization to Construct

STATESVILLE 704-878-5305 MOORESVILLE 704-664-5281

IMPROVEMENT PERMIT / ~~CERTIFICATE OF COMPLETION~~ / OPERATION PERMIT / EXISTING SYSTEM INSPECTION

PROPERTY DESCRIPTION NO. 23395 DATE 4/22/96 TAX MAP NO. 2A-6-A-25 Watershed: ☑ Yes ☐ No

OWNER OR CONTRACTOR James & Renee Bragle ~~PHONE: Business~~ PIN# 4645-32-0393 Home 331-8161

ADDRESS 6800 Streamside Dr Charlotte 28212

LOCATION Laytree: TR Corsons pl - end of rd - at Cul-de-sac.

SUBDIVISION Corson's Place BLOCK / SECTION ____ LOT 2 LOT AREA .84 ac SITE CLASS. PS DESIGN FLOW 450 gpd L.T.A.R. .3 gpd/sf

Septic Tank: 1000 Gallons; STB 794 Date 4/13/98

Pump Tank: ____ Gallons; PT ____ Date ____

Pump Make: ____ Model ____ Serial No. ____

Nitrification Field: No Fields 1 Square Feet 1200 Linear Feet 400

No Lines 4 Trench Width 36" Max Trench Bottom Depth 36"

☑ New System ☐ Repair System Type: I, II, (III), IV, V, VI

System Description: Gravity Chamberrock

Repair System Description: Same

Maintenance Agreement Required: ☐ Yes ☑ No

Gravel Depth N/A

☑ House/Mod. Home ☐ Mobile Home ☐ Business ☐ Other

No. Bedrooms 4 No. Bathrooms 4 No. Employees ____

☐ Slab ☑ Crawl Space ☐ Basement w/plumbing ☐ Basement wo/plumbing


Water Supply: ☑ Individual ☐ Community ☐ Public

Comments:

Comments: (CHANGED TO DISTRIBUTION BOX INSTEAD OF DROP BOXES)

1"=40'

INITIAL SITE SKETCH

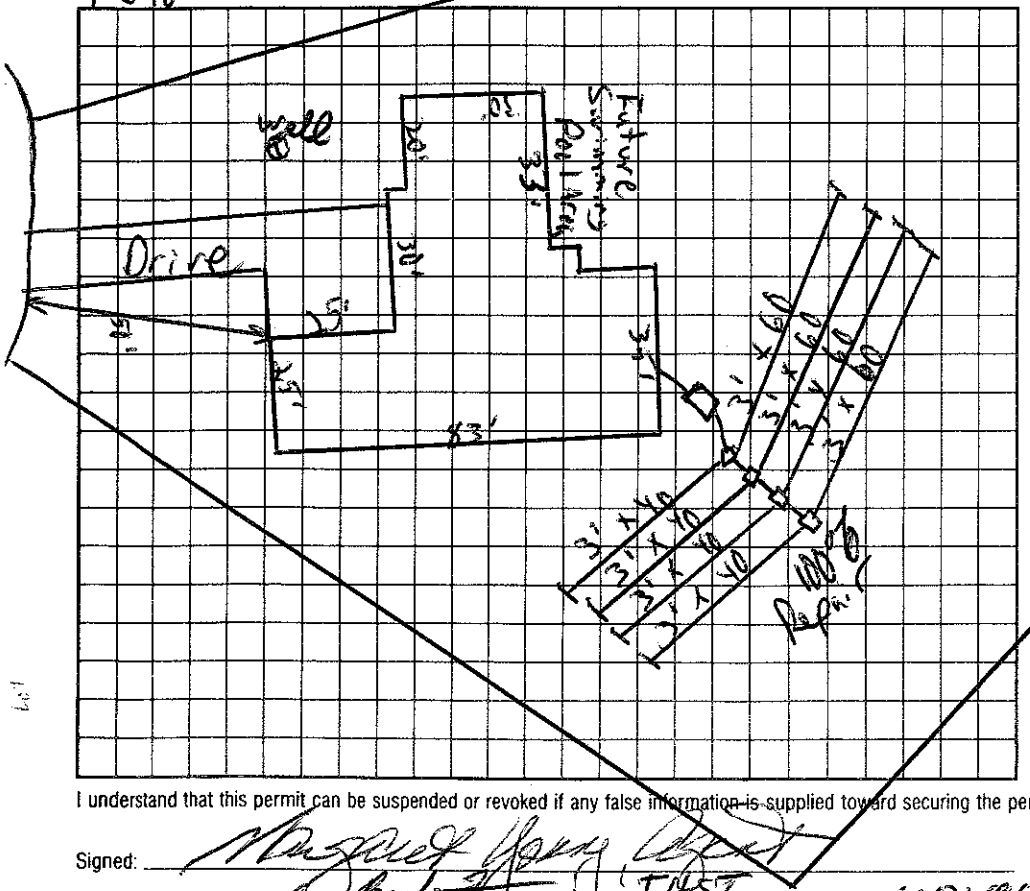

AS BUILT SKETCH

I understand that this permit can be suspended or revoked if any false information is supplied toward securing the permit/any unauthorized changes are made to the site/any unauthorized changes are made in the installation of the system.

Signed: Margaret Young

Installed by: Stephen Beatty

Improvement Permit by: Becky Keen EHSI date 4/22/96

Certificate of Completion by: ____ date ____

Existing System Inspection by: C. Becky Keen EHSI date 4/22/96

Operation Permit by: Becky Keen RS date 9/21/98

HEALTH DEPT. COPY: WHITE INSPECTION COPY (FINAL): GREEN OWNER COPY (FINAL): YELLOW INSPECTION COPY (INITIAL): PINK OWNER COPY (INITIAL): GOLD

Authorization to Construct is valid for 60 months from date of issue.