IREDELL COUNTY HEALTH DEPARTMENT

Authorization to Construct (2130)

STATESVILLE 704-878-5305 MOORESVILLE 704-664-5281

IMPROVEMENT PERMIT / ~~CERTIFICATE OF COMPLETION~~ / OPERATION PERMIT / EXISTING SYSTEM INSPECTION

PROPERTY DESCRIPTION NO. 069251 DATE 9/4/97 TAX MAP NO. 4645320479 Watershed: ☒ Yes ☐ No

OWNER OR CONTRACTOR Larry Bream PHONE: Business _____ Home 892-7373

ADDRESS c/o 19701-B Hwy 73 Cornelius, NC 28031

LOCATION 115 Turner Lain Ct. Cousons PR. TR 1st street, directly off Culdesac

SUBDIVISION Cousons Place BLOCK / SECTION II LOT 5 LOT AREA .81 SITE CLASS. PS DESIGN FLOW 360 L.T.A.R. .3

Septic Tank: 1000 Gallons; STB 794 Date 10/24/97

Pump Tank: _____ Gallons; PT _____ Date _____

Pump Make: _____ Model _____ Serial No. _____

Nitrification Field: No Fields 1 Square Feet 1200 Linear Feet 400

No Lines 5 Trench Width 36" Max Trench Bottom Depth 36" Gravel Depth 12"

☒ New System ☐ Repair System Type: I, ☒ II, III, IV, V, VI

System Description: CONVENTIONAL

Repair System Description: _____

Maintenance Agreement Required: ☐ Yes ☒ No

☒ House/Mod. Home No. Bedrooms 3

☐ Mobile Home No. Bathrooms 2.5

☐ Business No. Employees _____

☐ Other _____

☐ Slab ☒ Crawl Space ☐ Basement w/plumbing ☐ Basement wo/plumbing


Water Supply: ☒ Individual ☐ Community ☐ Public

Comments:


Comments:

INITIAL SITE SKETCH

1" = 50'

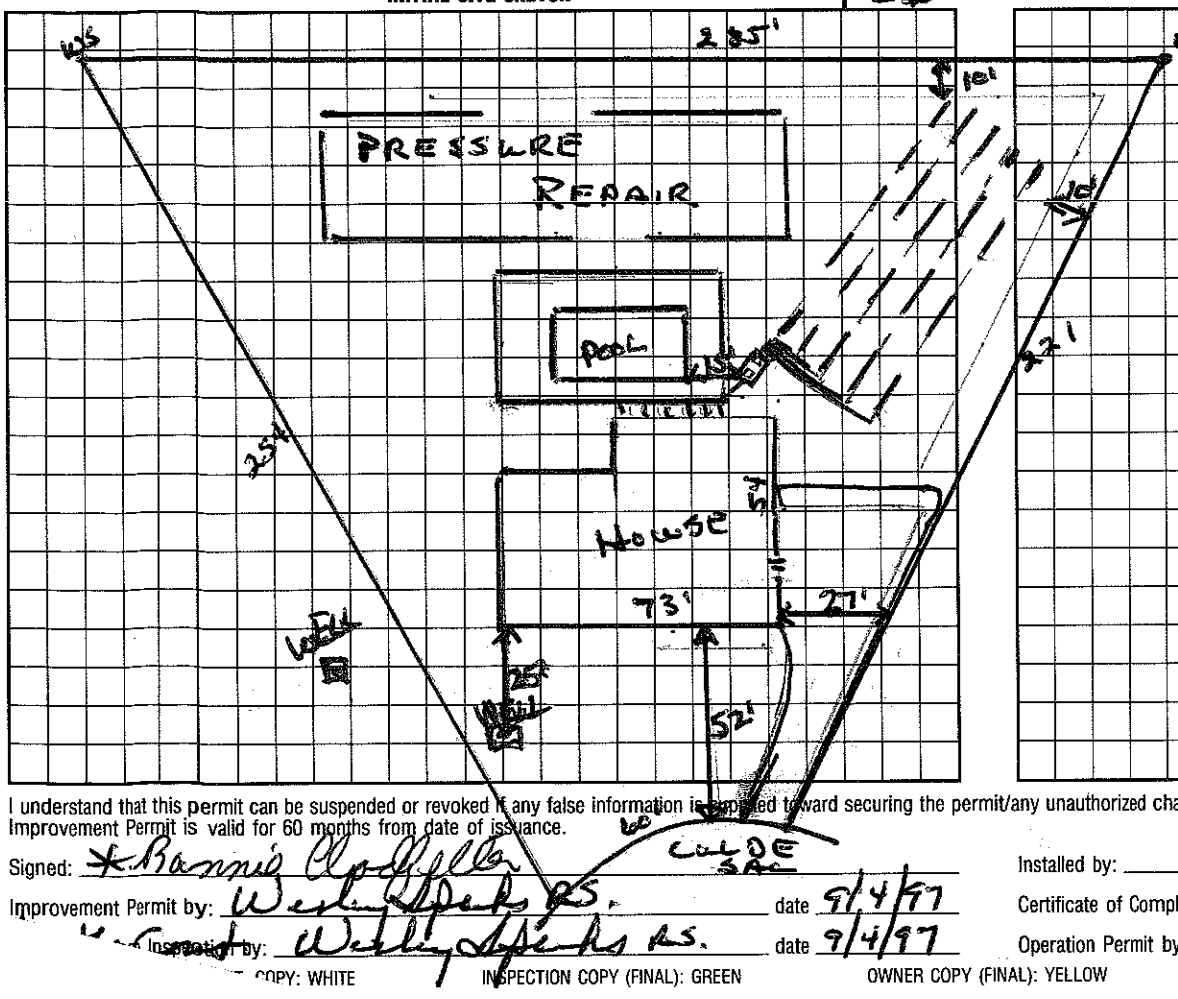

AS BUILT SKETCH

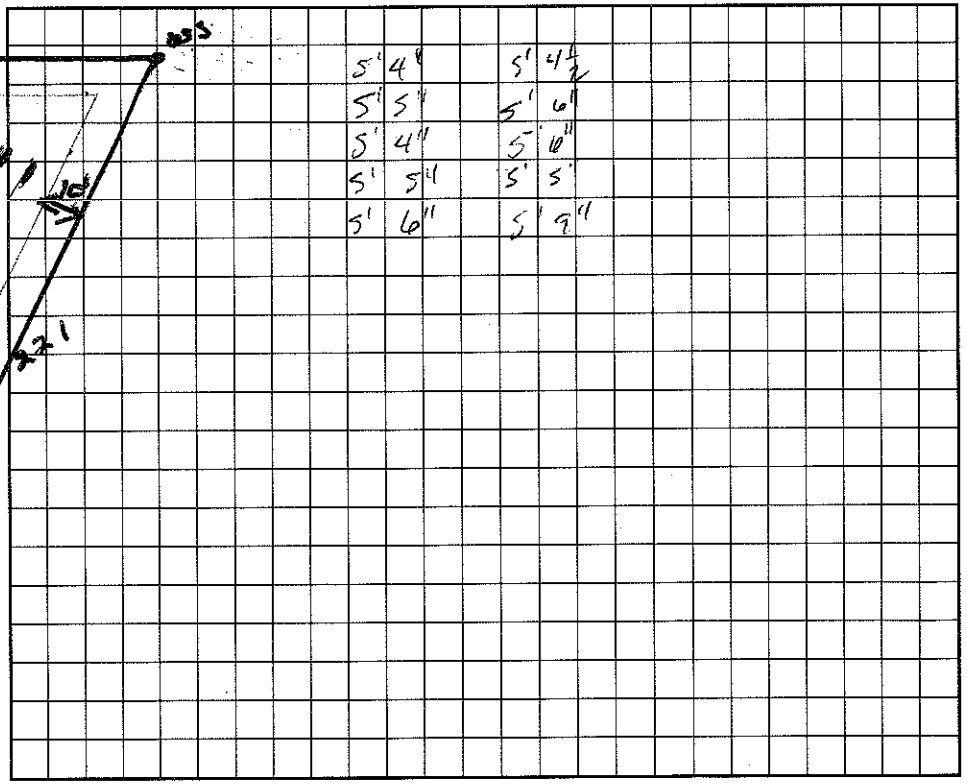

I understand that this permit can be suspended or revoked if any false information is supplied toward securing the permit/any unauthorized changes are made to the site/any unauthorized changes are made in the installation of the system. Improvement Permit is valid for 60 months from date of issuance.

Signed: Bonnie Applella

Improvement Permit by: Wesley Peeks RS. date 9/4/97

Inspection by: Wesley Peeks RS. date 9/4/97

Installed by: LARRY BEAM

Certificate of Completion by: _____ date _____

Operation Permit by: C. Thomas Jones date 3/3/98

COPY: WHITE INSPECTION COPY (FINAL): GREEN OWNER COPY (FINAL): YELLOW INSPECTION COPY (INITIAL): PINK OWNER COPY (INITIAL): GOLD