2nd

DELL COUNTY HEALTH DEPARTMENT

AUTH. INSTRUCT

STATESVILLE 704-878-5305 MOORESVILLE 704-664-5281

IMPROVEMENT PERMIT / ~~CERTIFICATE OF COMPLETION~~ / OPERATION PERMIT / EXISTING SYSTEM INSPECTION

PROPERTY DESCRIPTION NO. 25211 DATE 9/26/96 TAX MAP NO. 2A-6-A-23 / 4645-32-0631 Watershed: ☑ Yes ☐ No

OWNER OR CONTRACTOR ABJ CONSTRUCTION PHONE: Business 664-4353 Home

ADDRESS 1154 BRAWLEY SCHOOL MOORESVILLE 28115

LOCATION 115S - TR LANETREE - TR CARSONS PLACE - TR TURNBERCLAER . 2nd LOT ON LEFT

SUBDIVISION CARSONS PLACE BLOCK / SECTION II LOT 4 LOT AREA - SITE CLASS. AS DESIGN FLOW 360GD L.T.A.R. .30-NN/FT²

Septic Tank: 1000 Gallons; STB 794 Date 4/9/97

Pump Tank: Gallons; PT Date

Pump Make: Model Serial No.

Nitrification Field: No Fields 1 Square Feet 1260 Linear Feet 460

No Lines 5 Trench Width 36" Max Trench Bottom Depth 36" Gravel Depth 12"

☑ New System ☐ Repair System Type: I (II) III, IV, V, VI

System Description: GRAVITY CONVENTIONAL

Repair System Description: PUMP CONVENTIONAL

Maintenance Agreement Required: ☐ Yes ☑ No

☑ House/Mod. Home ☐ Mobile Home ☐ Business ☐ Other

No. Bedrooms 3 No. Bathrooms 3 No. Employees


☐ Slab ☑ Crawl Space ☐ Basement w/plumbing ☐ Basement wo/plumbing

Water Supply: ☑ Individual ☐ Community ☐ Public


Comments:

Comments:

INITIAL SITE SKETCH 1"=50'

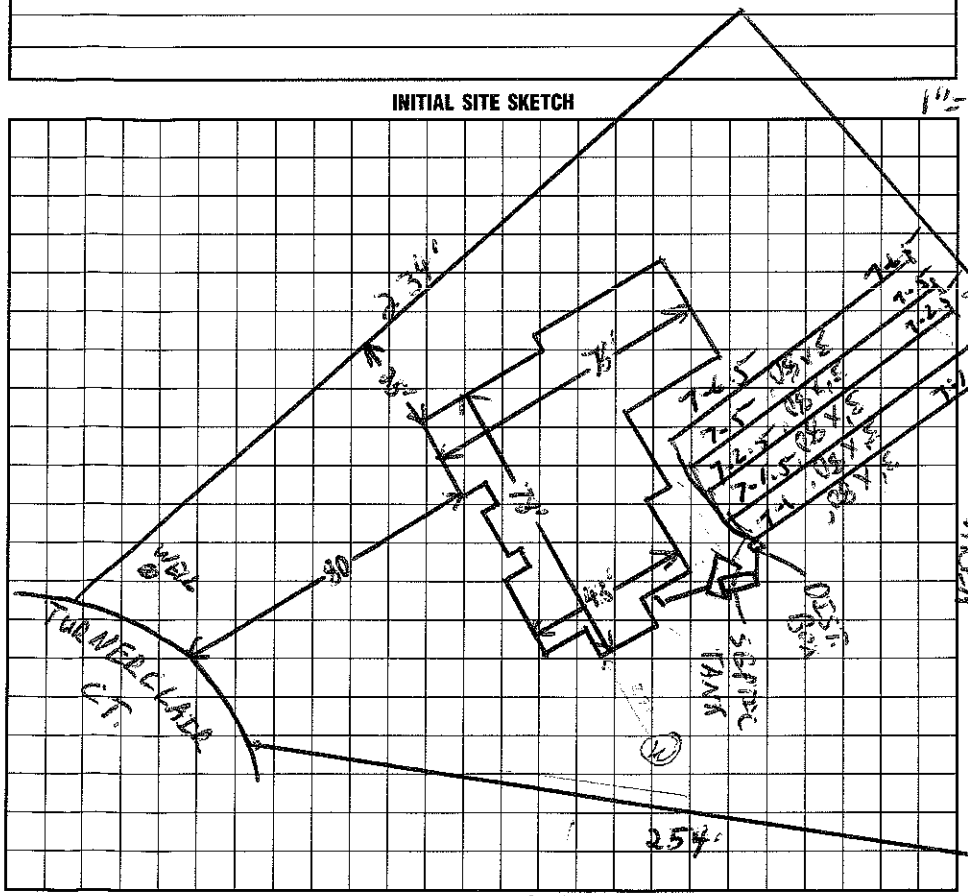

AS BUILT SKETCH

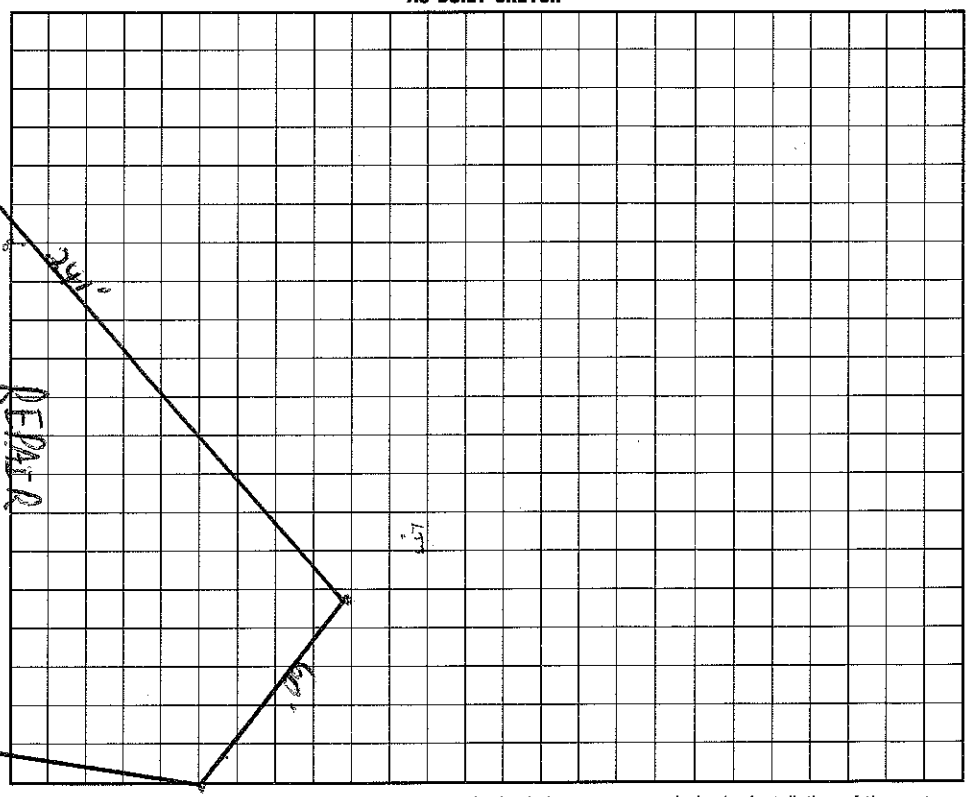

I understand that this permit can be suspended or revoked if any false information is supplied toward securing the permit/any unauthorized changes are made to the site/any unauthorized changes are made in the installation of the system.

Signed: ABJ BY

Improvement Permit by: [signature] EHS date 9/26/96

Existing System Inspection by: [signature] EHS date 9/26/96

AUTHORIZATION TO CONSTRUCT

Installed by: F.J. Ervin

Certificate of Completion by: Wayley Sparks RS. date 6/23/97

Operation Permit by: Wayley Sparks RS date 6/23/97

HEALTH DEPT. COPY: WHITE INSPECTION COPY (FINAL): GREEN OWNER COPY (FINAL): YELLOW INSPECTION COPY (INITIAL): PINK OWNER COPY (INITIAL): GOLD