(3:30)

IREDELL COUNTY HEALTH DEPARTMENT

Const. Auth. STATESVILLE 704-878-5305 MOORESVILLE 704-664-5281

IMPROVEMENT PERMIT / ~~CERTIFICATE OF COMPLETION~~ / OPERATION PERMIT / EXISTING SYSTEM INSPECTION

PROPERTY DESCRIPTION NO. 24313 DATE July 27, '96 TAX MAP NO. 2A6A24 | 4645-32-0960 Watershed: ☑ Yes ☐ No

OWNER OR CONTRACTOR Robert Jacks Jr. / Gerald Hymer PHONE: Business 664-9329 Home

ADDRESS 134 Smithstone Mooresville

LOCATION Langtree Road TR into Carsons Place ~¼ mile on Right

SUBDIVISION Carsons Place BLOCK / SECTION LOT 24 LOT AREA .82 Ac SITE CLASS 95 DESIGN FLOW 480 gpd L.T.A.R. .3-.35

Septic Tank: 1000 Gallons; STB 794 Date 3/6/97

Pump Tank: Gallons; PT Date

Pump Make: Model Serial No.

Nitrification Field: No Fields 1 Square Feet 1170+ Linear Feet 390+

No Lines 4 Trench Width 36" Max Trench Bottom Depth ~36" Gravel Depth NA

☑ New System ☐ Repair System Type: I, II, (III), IV, V, VI

System Description: gravity chambered

Repair System Description: pumped conventional

Maintenance Agreement Required: ☐ Yes ☑ No

☑ House/Mod. Home No. Bedrooms 4

☐ Mobile Home No. Bathrooms 3½

☐ Business No. Employees

☐ Other

☐ Slab ☑ Crawl Space ☐ Basement w/plumbing ☐ Basement wo/plumbing


Water Supply: ☑ Individual ☐ Community ☐ Public

Comments: Plumbing must be exited above footing and at existing grade. Backfill against house in order to avoid pump.


Comments:

1" = 50'

INITIAL SITE SKETCH

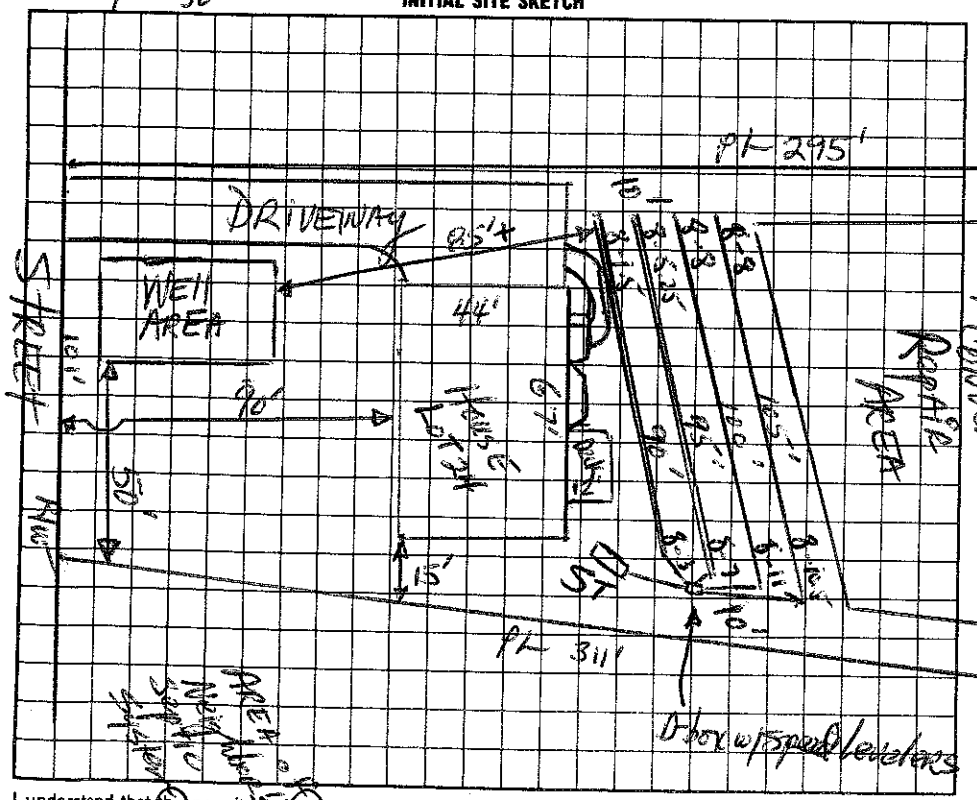

AS BUILT SKETCH

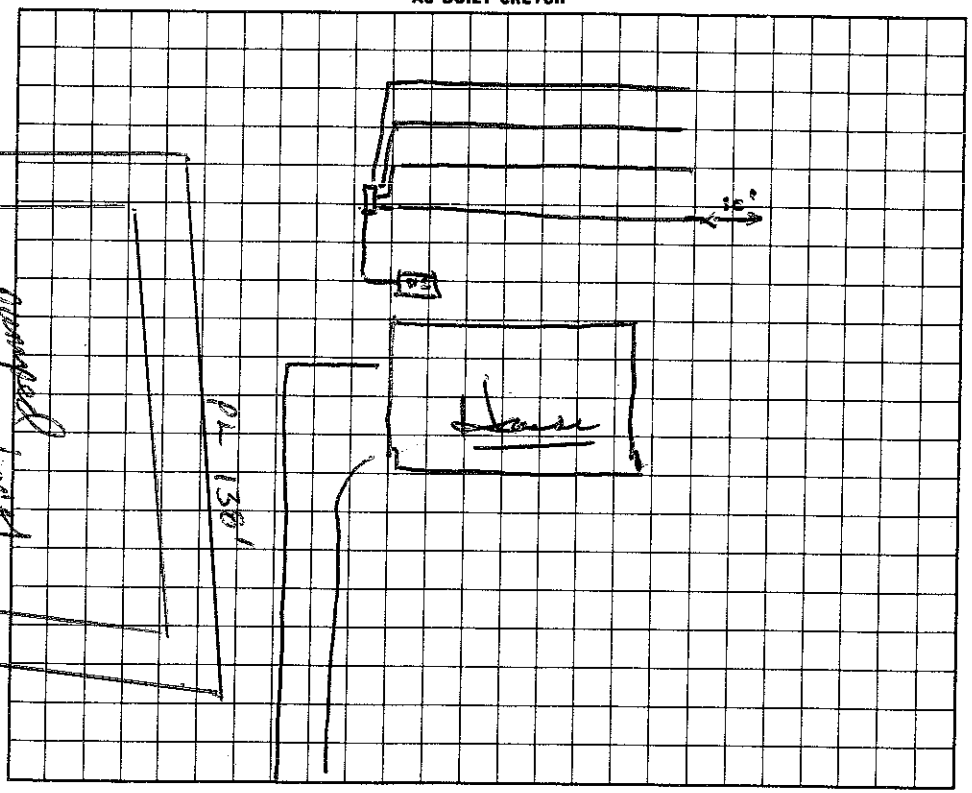

I understand that this permit can be suspended or revoked if any false information is supplied toward securing the permit/any unauthorized changes are made to the site/any unauthorized changes are made in the installation of the system.

Signed: Robert E. Jacks

Improvement Permit by: Gerald R. Hymer, RS date 7-27-96

~~CONSTRUCTION~~ Existing System Inspection by: Gerald R. Hymer, RS date 7-27-96

AUTHORIZATION TO PROCEED

Installed by: Tim Simmons

Certificate of Completion by: Wesley Sparks RS. date 5/22/97

Operation Permit by: Wesley Sparks RS. date 5/22/97

HEALTH DEPT. COPY: WHITE INSPECTION COPY (FINAL): GREEN OWNER COPY (FINAL): YELLOW INSPECTION COPY (INITIAL): PINK OWNER COPY (INITIAL): GOLD