PIN# 4645-33-0071

IREDELL COUNTY HEALTH DEPARTMENT

STATESVILLE 704-878-5305 MOORESVILLE 704-664-5281

IMPROVEMENT PERMIT / CERTIFICATE OF COMPLETION / OPERATION PERMIT / EXISTING SYSTEM INSPECTION

PROPERTY DESCRIPTION NO. 2095 DATE 4-25-95 TAX MAP NO. 2A-6-4-19 Watershed: ☑ Yes ☐ No

OWNER OR CONTRACTOR Robert E. Jacks PHONE: Business 892-6570 Home

ADDRESS PO Box 5000-269 Mooresville WSIV CA

LOCATION 1155 TR Tanyard TR Carson's Place on Rt

SUBDIVISION Carson's Place BLOCK / SECTION 2 LOT 23 LOT AREA 110'X295' SITE CLASS. PS DESIGN FLOW 480 L.T.A.R. .32

Septic Tank: 1000 Gallons; STB 794 Date 9/6/95

Pump Tank: Gallons; PT Date

Pump Make: Model Serial No.

Nitrification Field: No Fields 1 Square Feet 1500 Linear Feet 500

No Lines 4 Trench Width 36" Max Trench Bottom Depth 36" Gravel Depth 12"

☑ New System ☐ Repair System Type: I, II, III, IV, V, VI

System Description: Conv. Gravity

Repair System Description: Gravity Rocked

Maintenance Agreement Required: ☐ Yes ☑ No

☑ House/Mod. Home No. Bedrooms 4

☐ Mobile Home No. Bathrooms 3

☐ Business No. Employees

☐ Other


☐ Slab ☑ Crawl Space ☐ Basement w/plumbing ☐ Basement wo/plumbing

Water Supply: ☑ Individual ☐ Community ☐ Public


Comments: use speed levelers in P. Box

Comments:
11/6/95 No well on site
11/6/95 Well location must conform to 2C Well Regulations

INITIAL SITE SKETCH

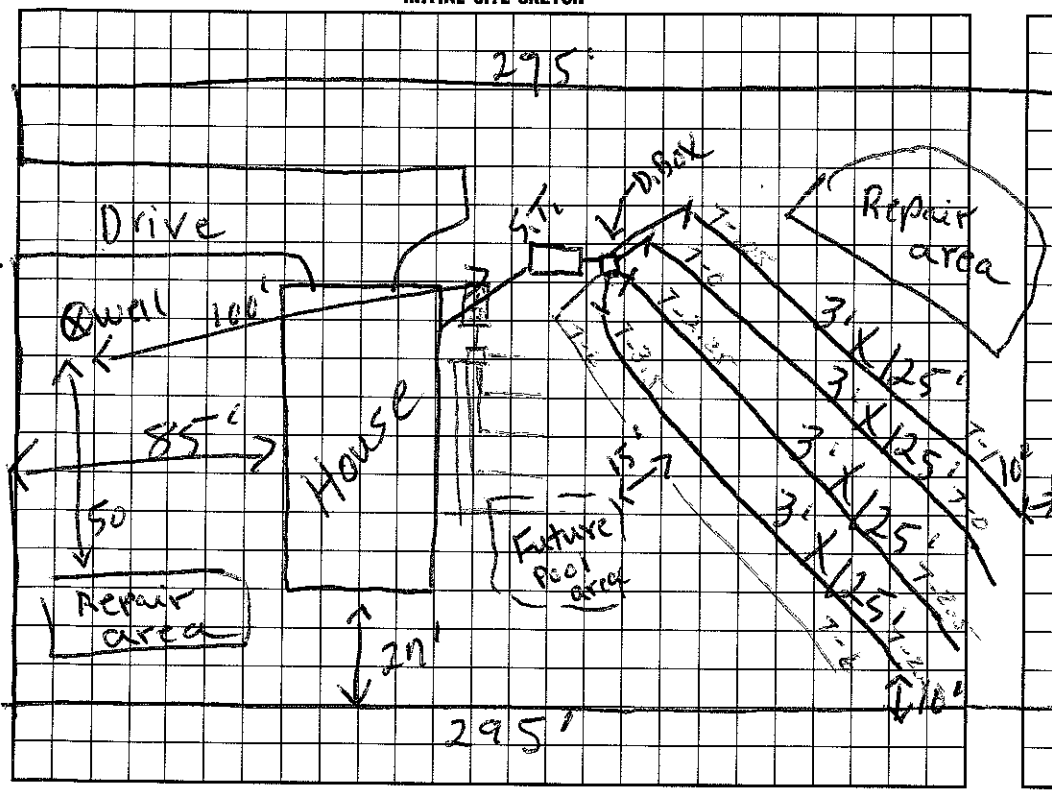

AS BUILT SKETCH

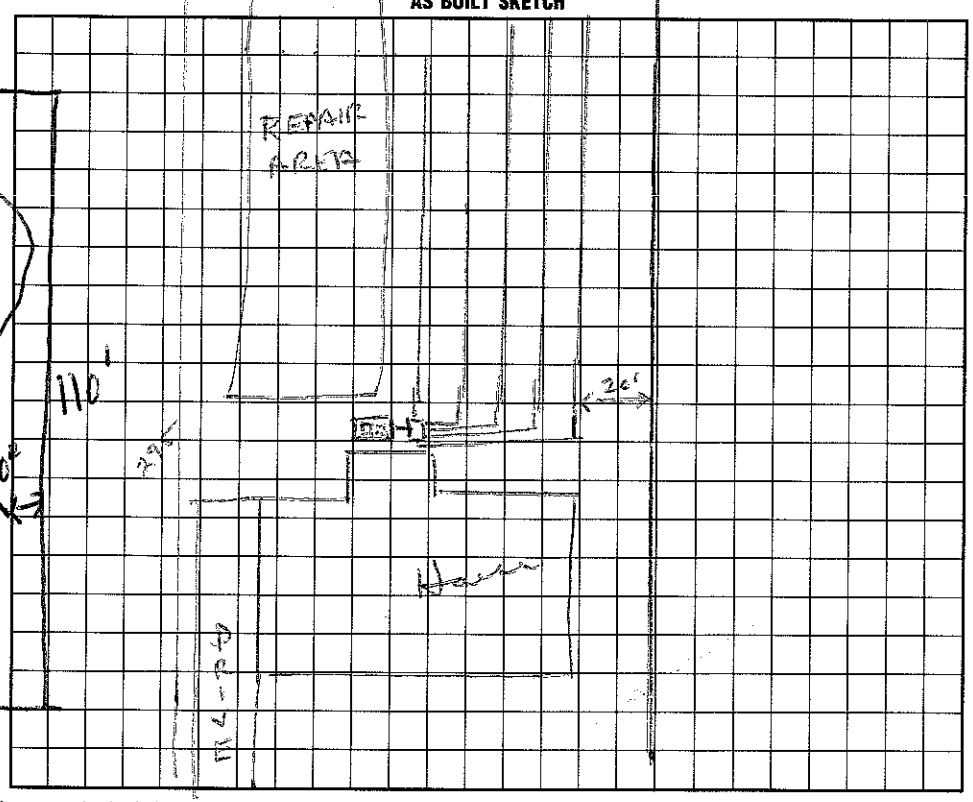

I understand that this permit can be suspended or revoked if any false information is supplied toward securing the permit/any unauthorized changes are made to the site/any unauthorized changes are made in the installation of the system. Improvement Permit is valid for 60 months from date of issuance.

Signed: X Robert E. Jacks

Improvement Permit by: J. C. Moore date 4-25-95

Existing System Inspection by: date

Installed by: F J Ennis

Certificate of Completion by: Wesley Sparks R.S. date 11/6/95

Operation Permit by: Wesley Sparks R.S. date 11/6/95

HEALTH DEPT. COPY: WHITE INSPECTION COPY (FINAL): GREEN OWNER COPY (FINAL): YELLOW INSPECTION COPY (INITIAL): PINK OWNER COPY (INITIAL): GOLD